


Lots 8 & 9

Blk 6



Beaver Lake Heights

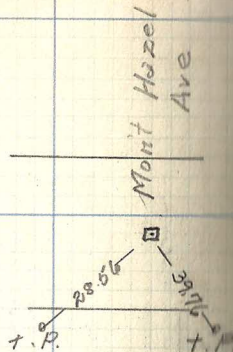

40

Iroquois

66

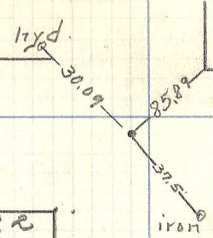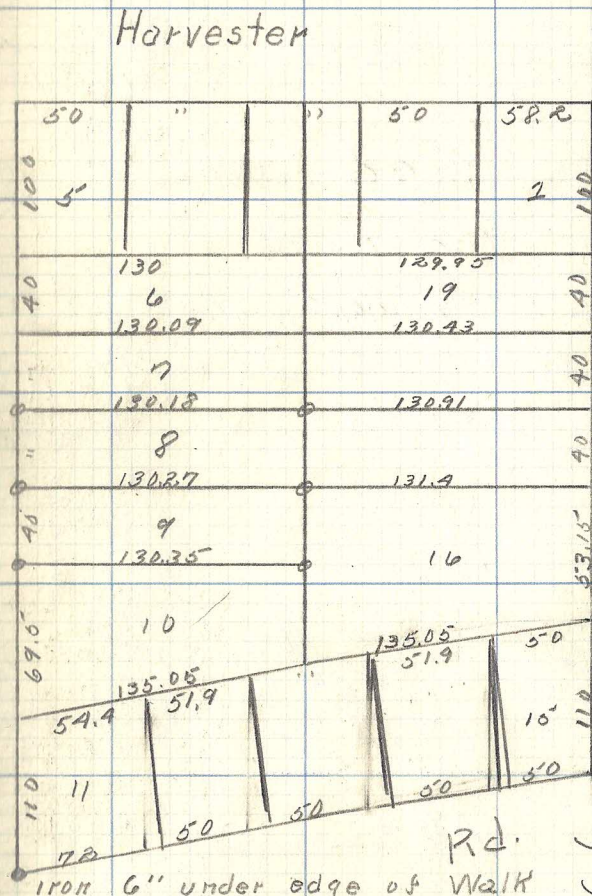

Ruth Ave

45

Rd.

Stillwater