Lots 4 & 17
Blk 27
Rice & Irvine's
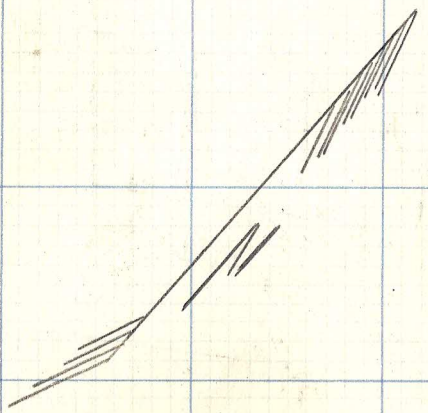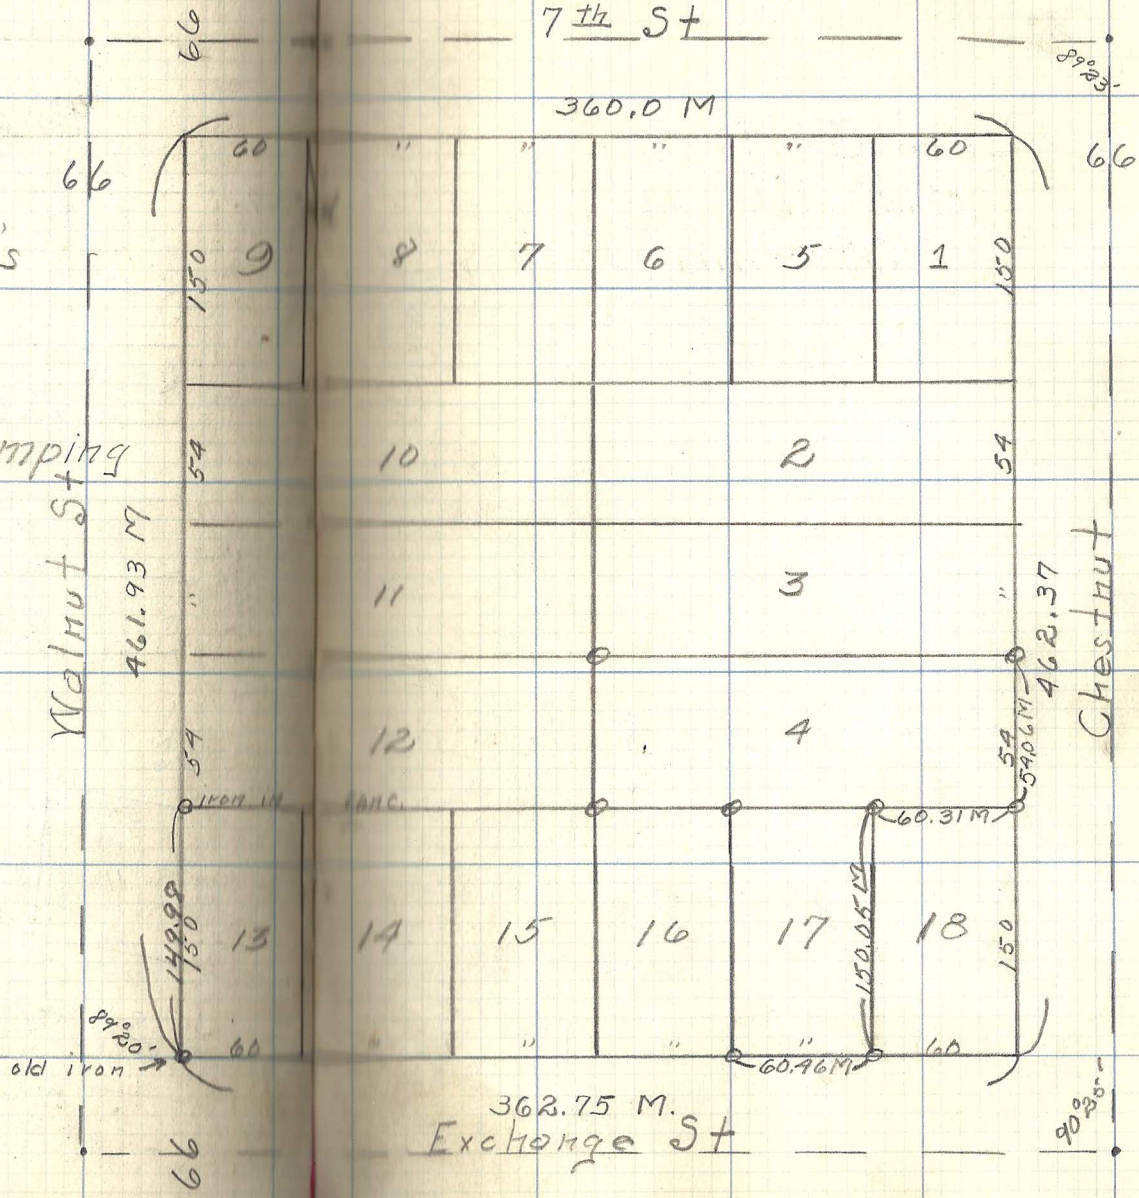
Bldg locations
Survey for
Western Stamping
Works