


Lot 11
 BIK 98
 Banning & Oliver's Add




Seminole

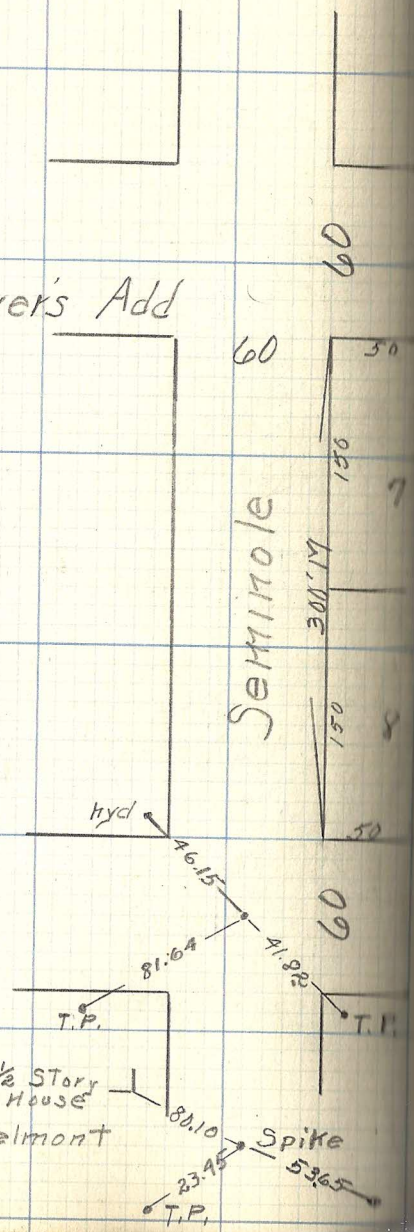

Mont approx 111.3 N. of & Baker

Brick Pier

Page

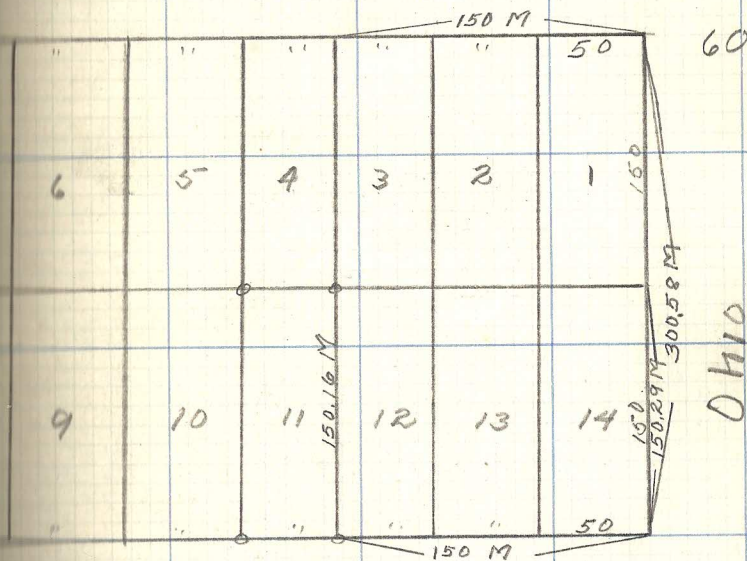

Sydney

nails in oak