Lot 13
Blk 2
Sargent's Add

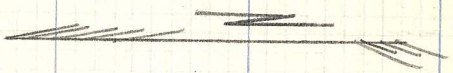



60 Albert S.

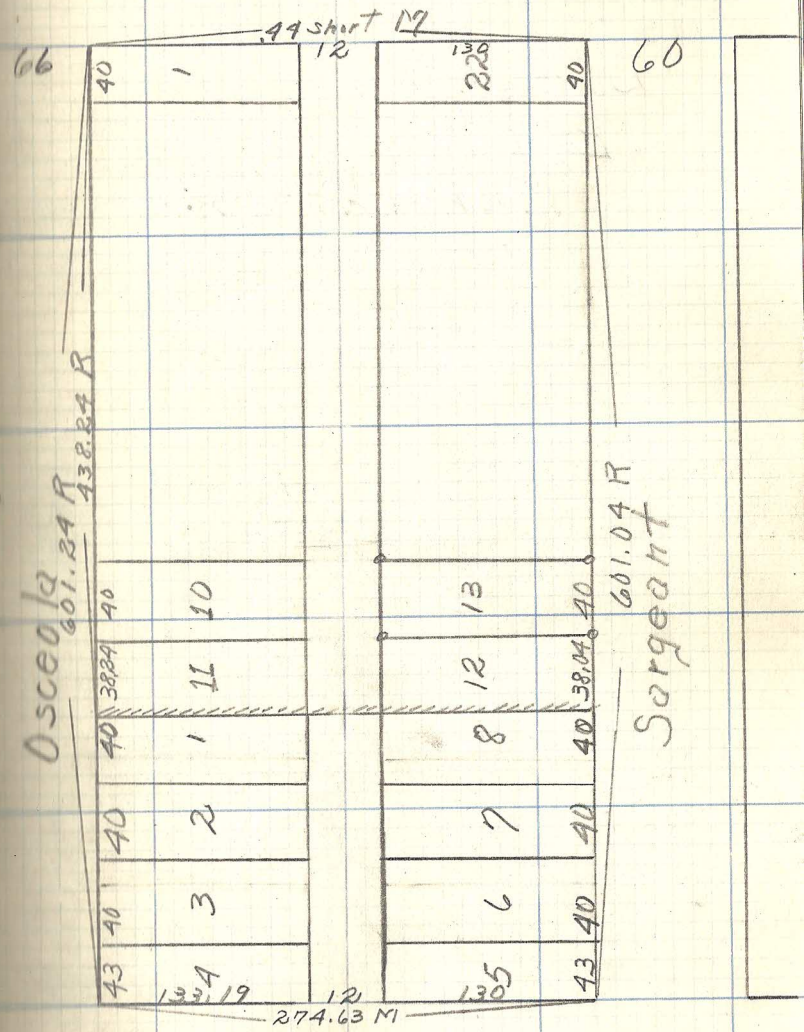


60 Pascal S.