
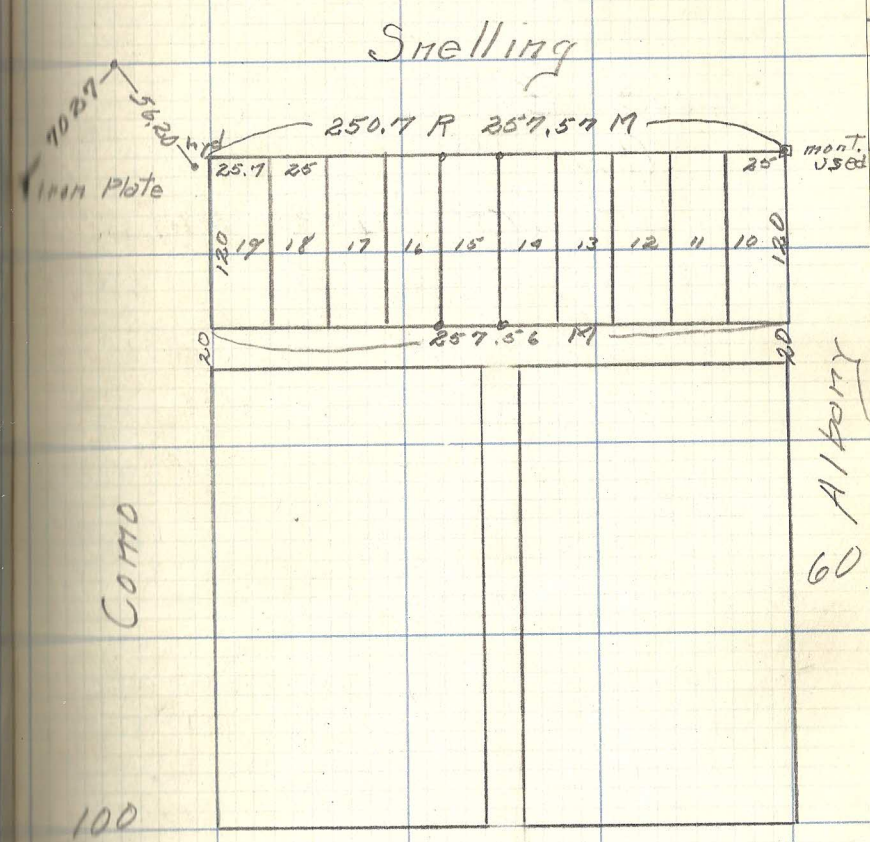


Lot 15  
B1K 7  
Lake Park Add.

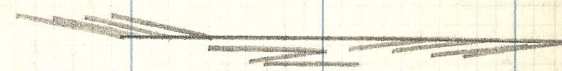

Arond

Mont & Como AT Hamline