


W. 785.68 ft. of N $\frac{1}{2}$  of NE.  $\frac{1}{4}$  of N.W.  $\frac{1}{4}$

Sec. 29-30-23

Mar. 22-27

Caroline Blonski

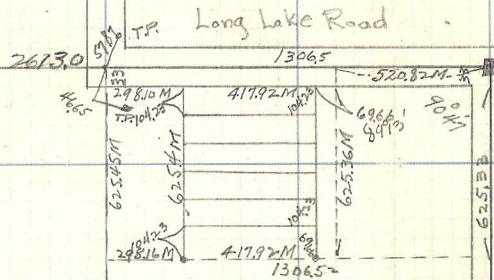

2613.18