


Lot 8
Blk 3
Mid Heights Add

June 12, 1928

G.N.R.R. Co.

60

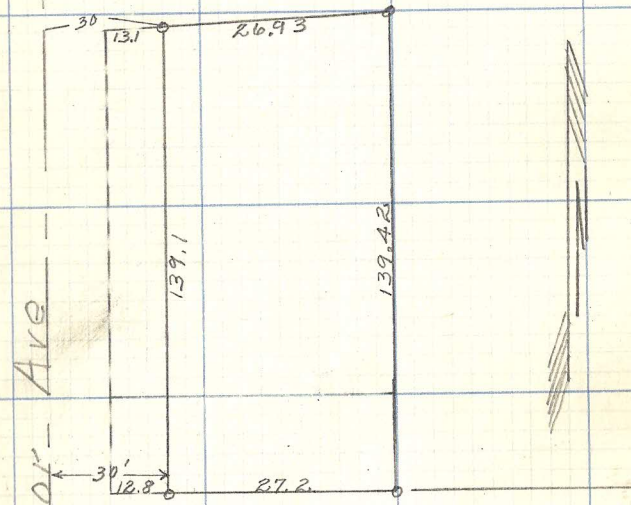

50

Hilles Ave

60