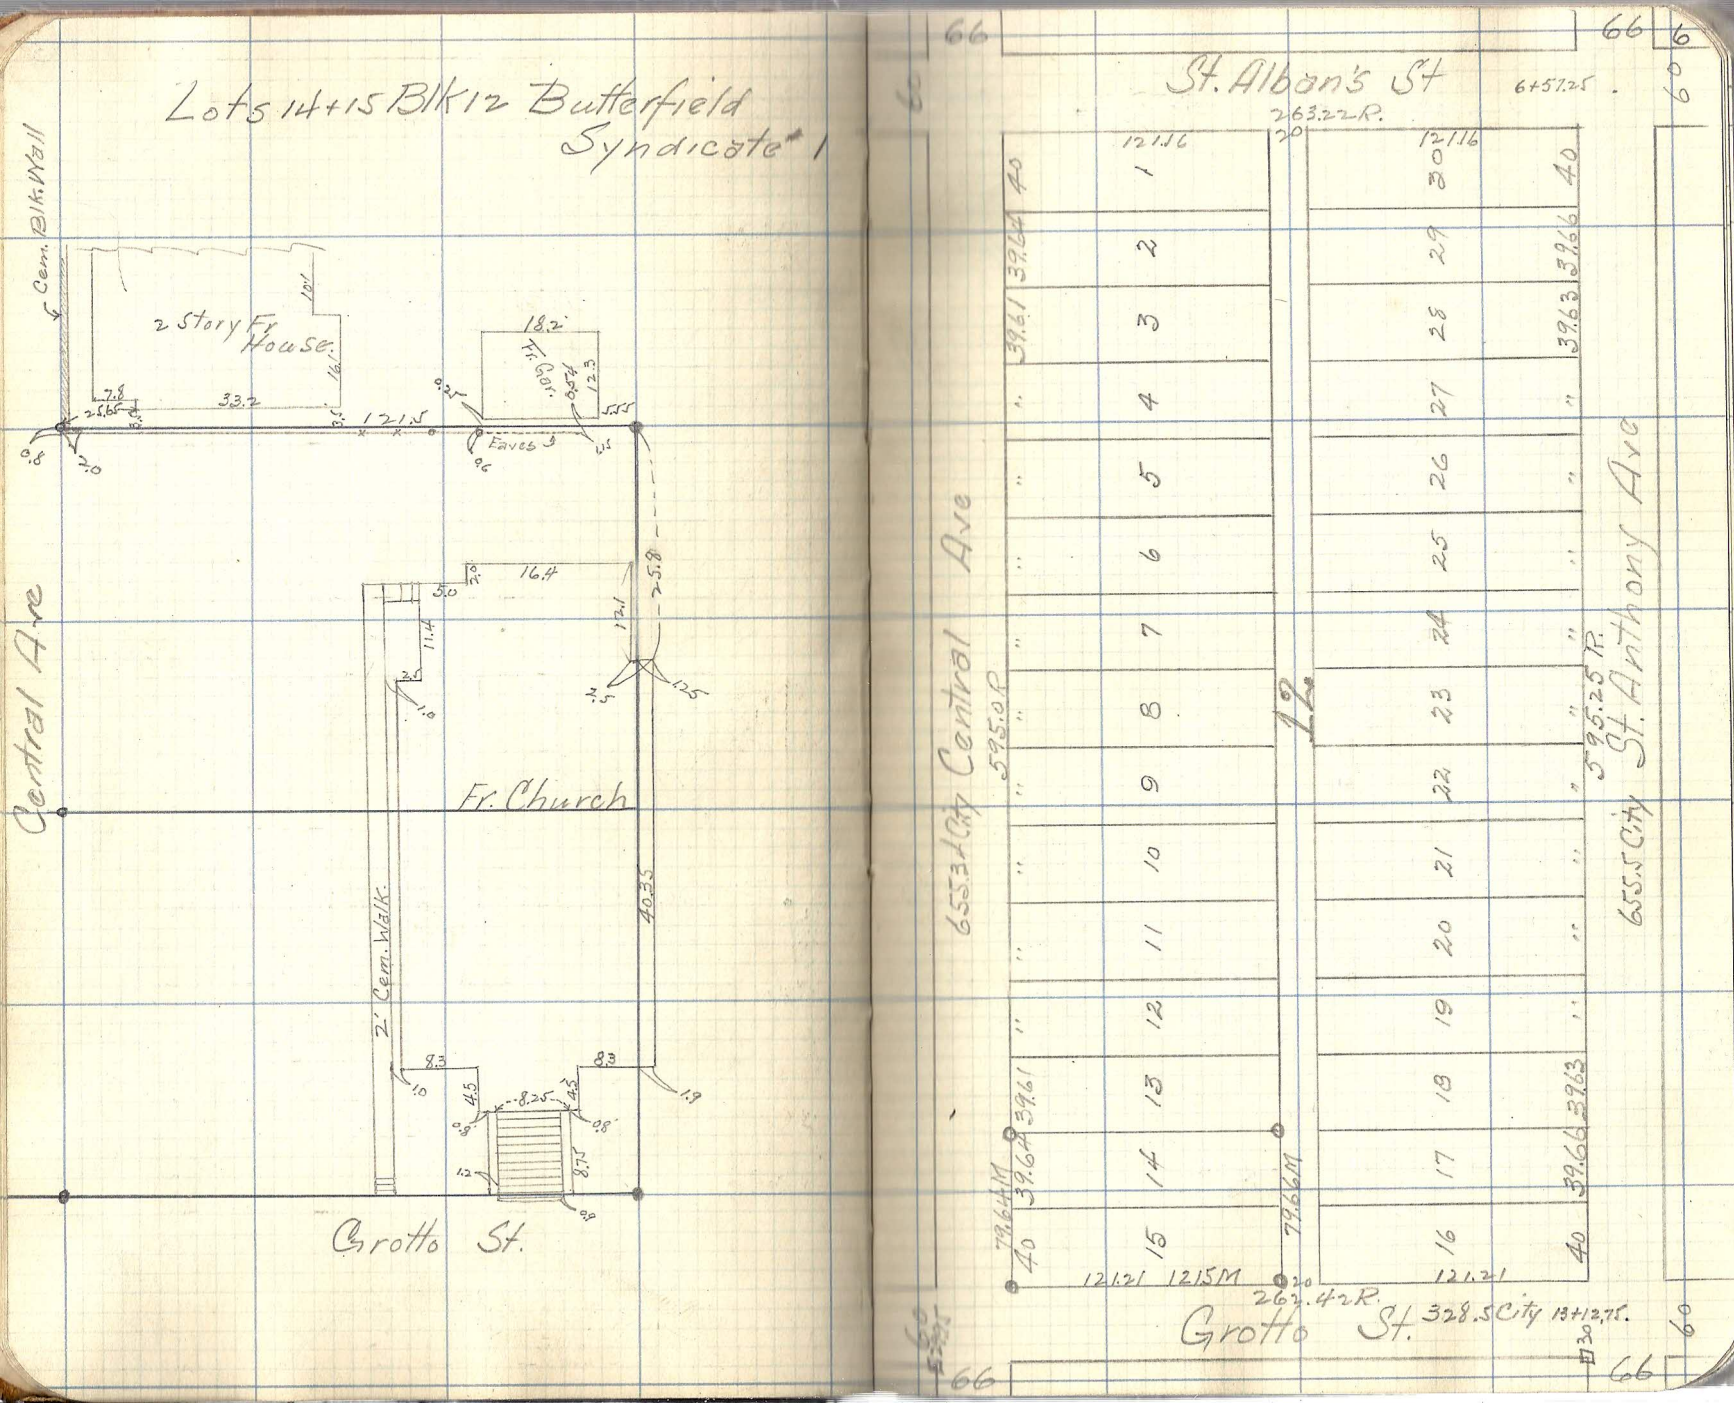
Lots 14+15 Blk 12 Butterfield
Syndicate # 1
Cem. Blk. Wall
2 Story Fr. House
Fr. Gar.
Eaves
Central Ave
Fr. Church
2' Cem. Walk
Grotto St.
St. Alban's St
6+57.25
263.22 R.
121.16
121.16
655.3 City Central Ave
595.0 R.
12
655.5 City St. Anthony Ave
595.25 R.
79.64 M
79.66 M
121.21
121.21
262.42 R.
328.5 City 13+12.75
Grotto St.