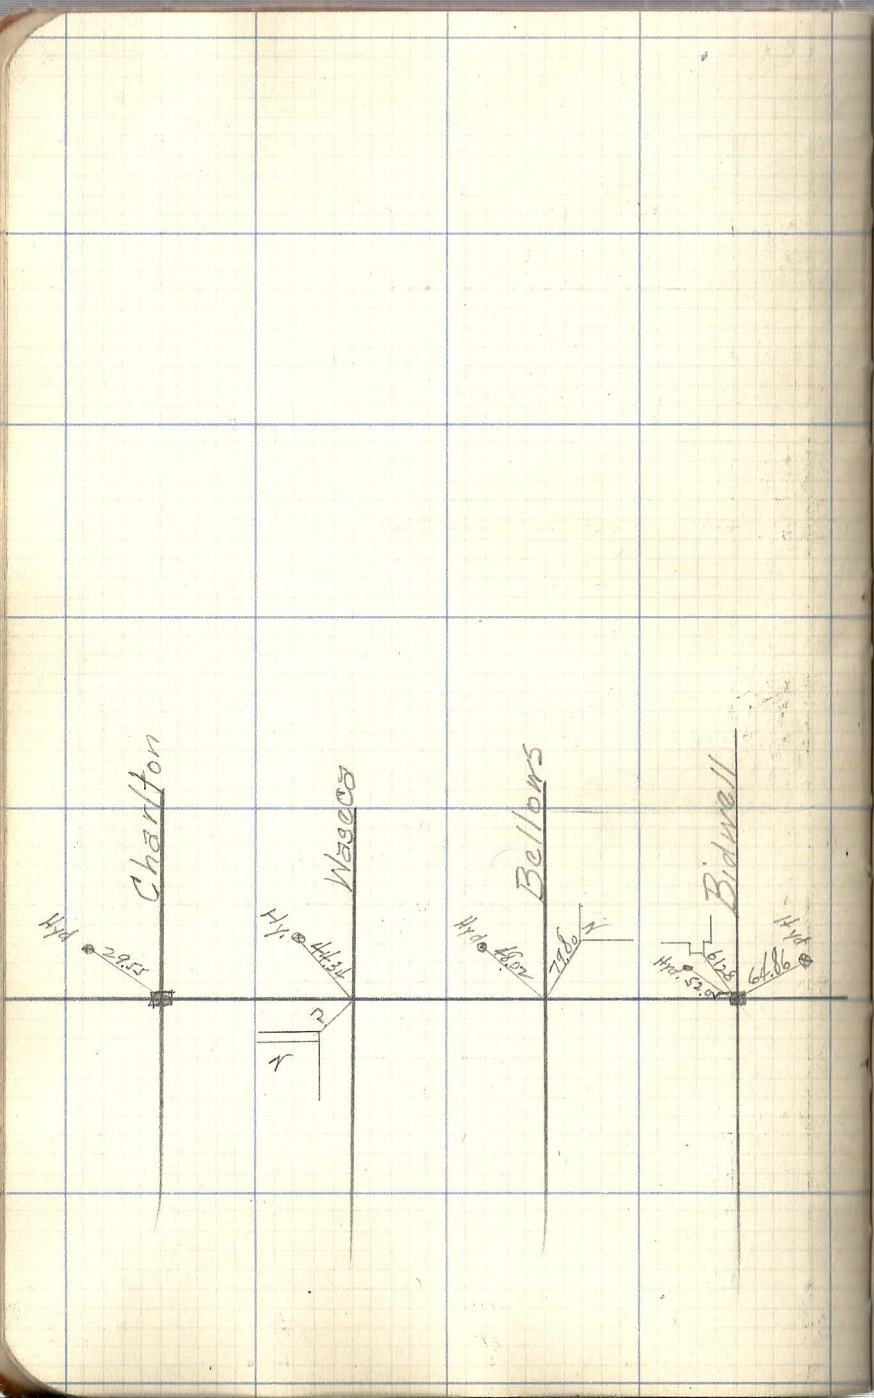
Charlton
Waseca
Bellows
Bidwell
Hyd 29.55
Hyd 44.34
Hyd 48.02
79.80
Hyd 52.05
61.28
64.86

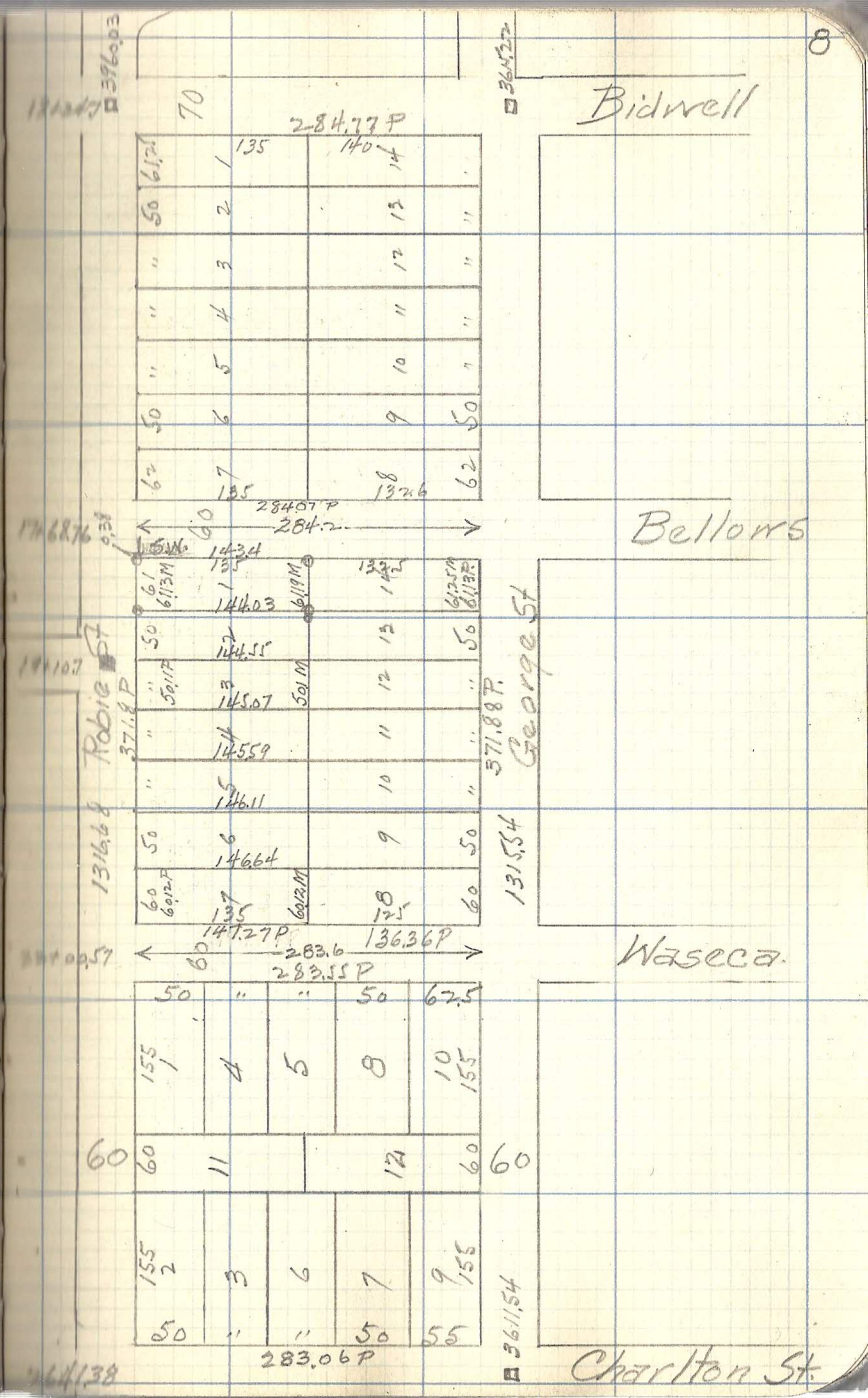
Bidwell
Bellows
Waseca
Charlton St.
Robie St
George St
284.77 P
284.07 P
284.2
371.8 P
371.88 P
1316.68
1315.54
147.27 P
136.36 P
283.6
283.55 P
283.06 P
3960.03
3615.22
3611.54
60
70