Lots 14+15 Blk 1
Edgecliffe Add No 2
Shepley's Add.
May 16-27
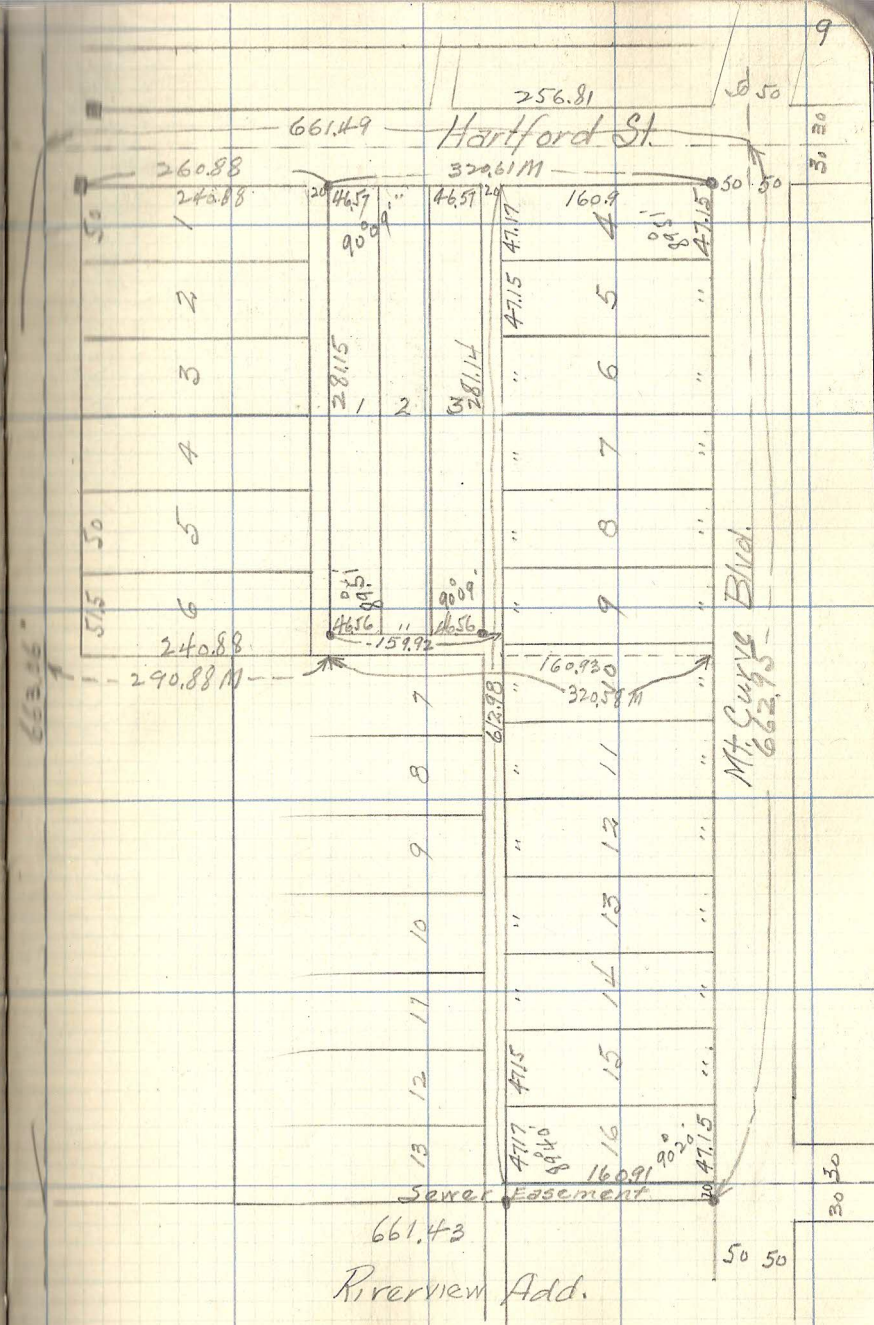
Joseph L. Shepley Owner