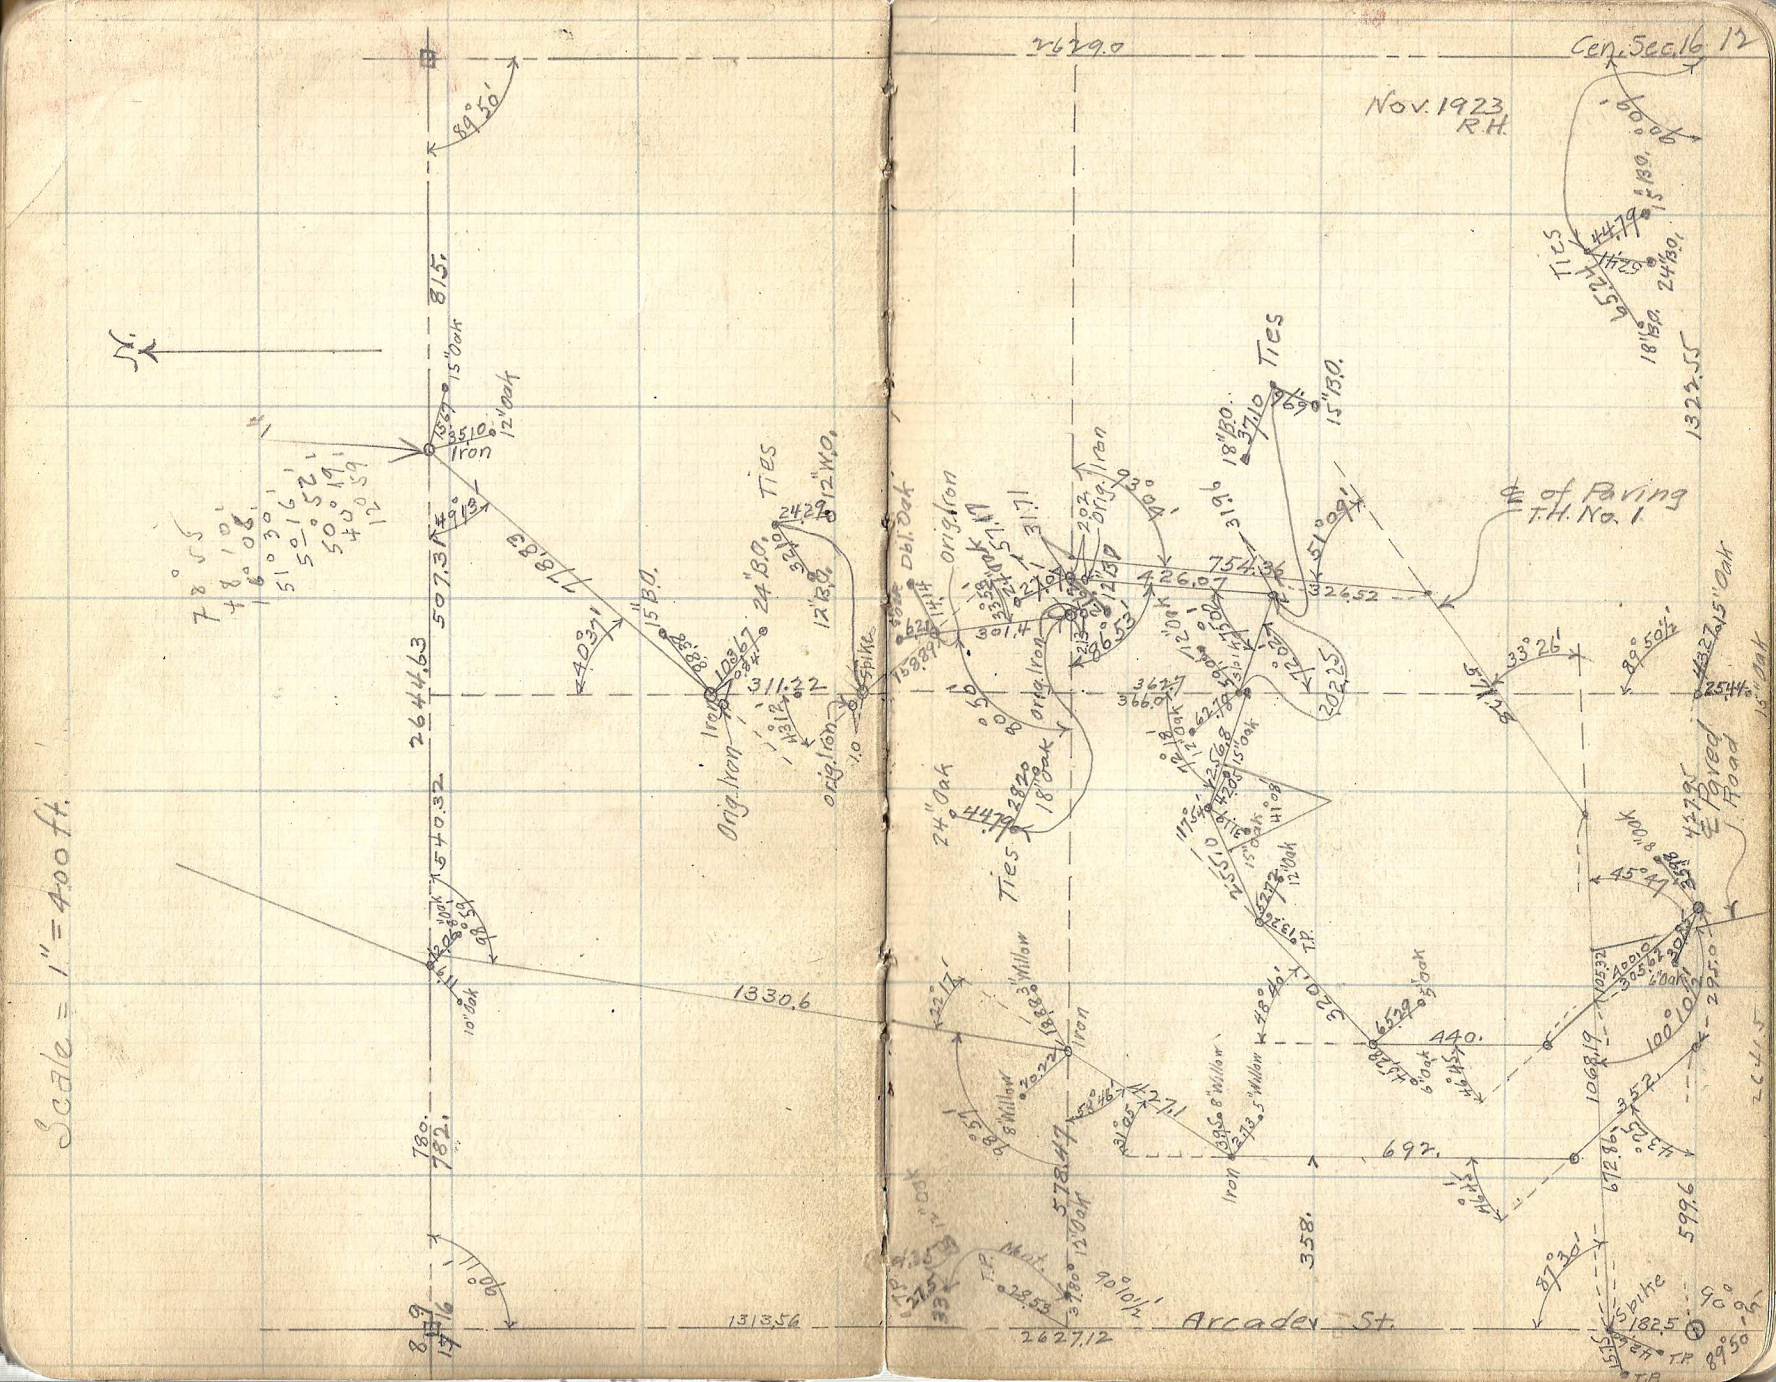
Cen. Sec. 16
12
Nov. 1923
R.H.
Scale = 1" = 400 ft.
N
2629.0
815.
507.31
2644.63
540.32
780.
782.
1330.6
1313.56
2627.12
Arcade St.
Spike
Iron
Ties
Orig. Iron
Dbl. Oak
℄ of Paving
T.H. No. 1
℄ Paved Road
1322.55
754.36
426.07
326.52
440.
692.
358.
599.6
1068.19
1182.5
Meat
T.P.