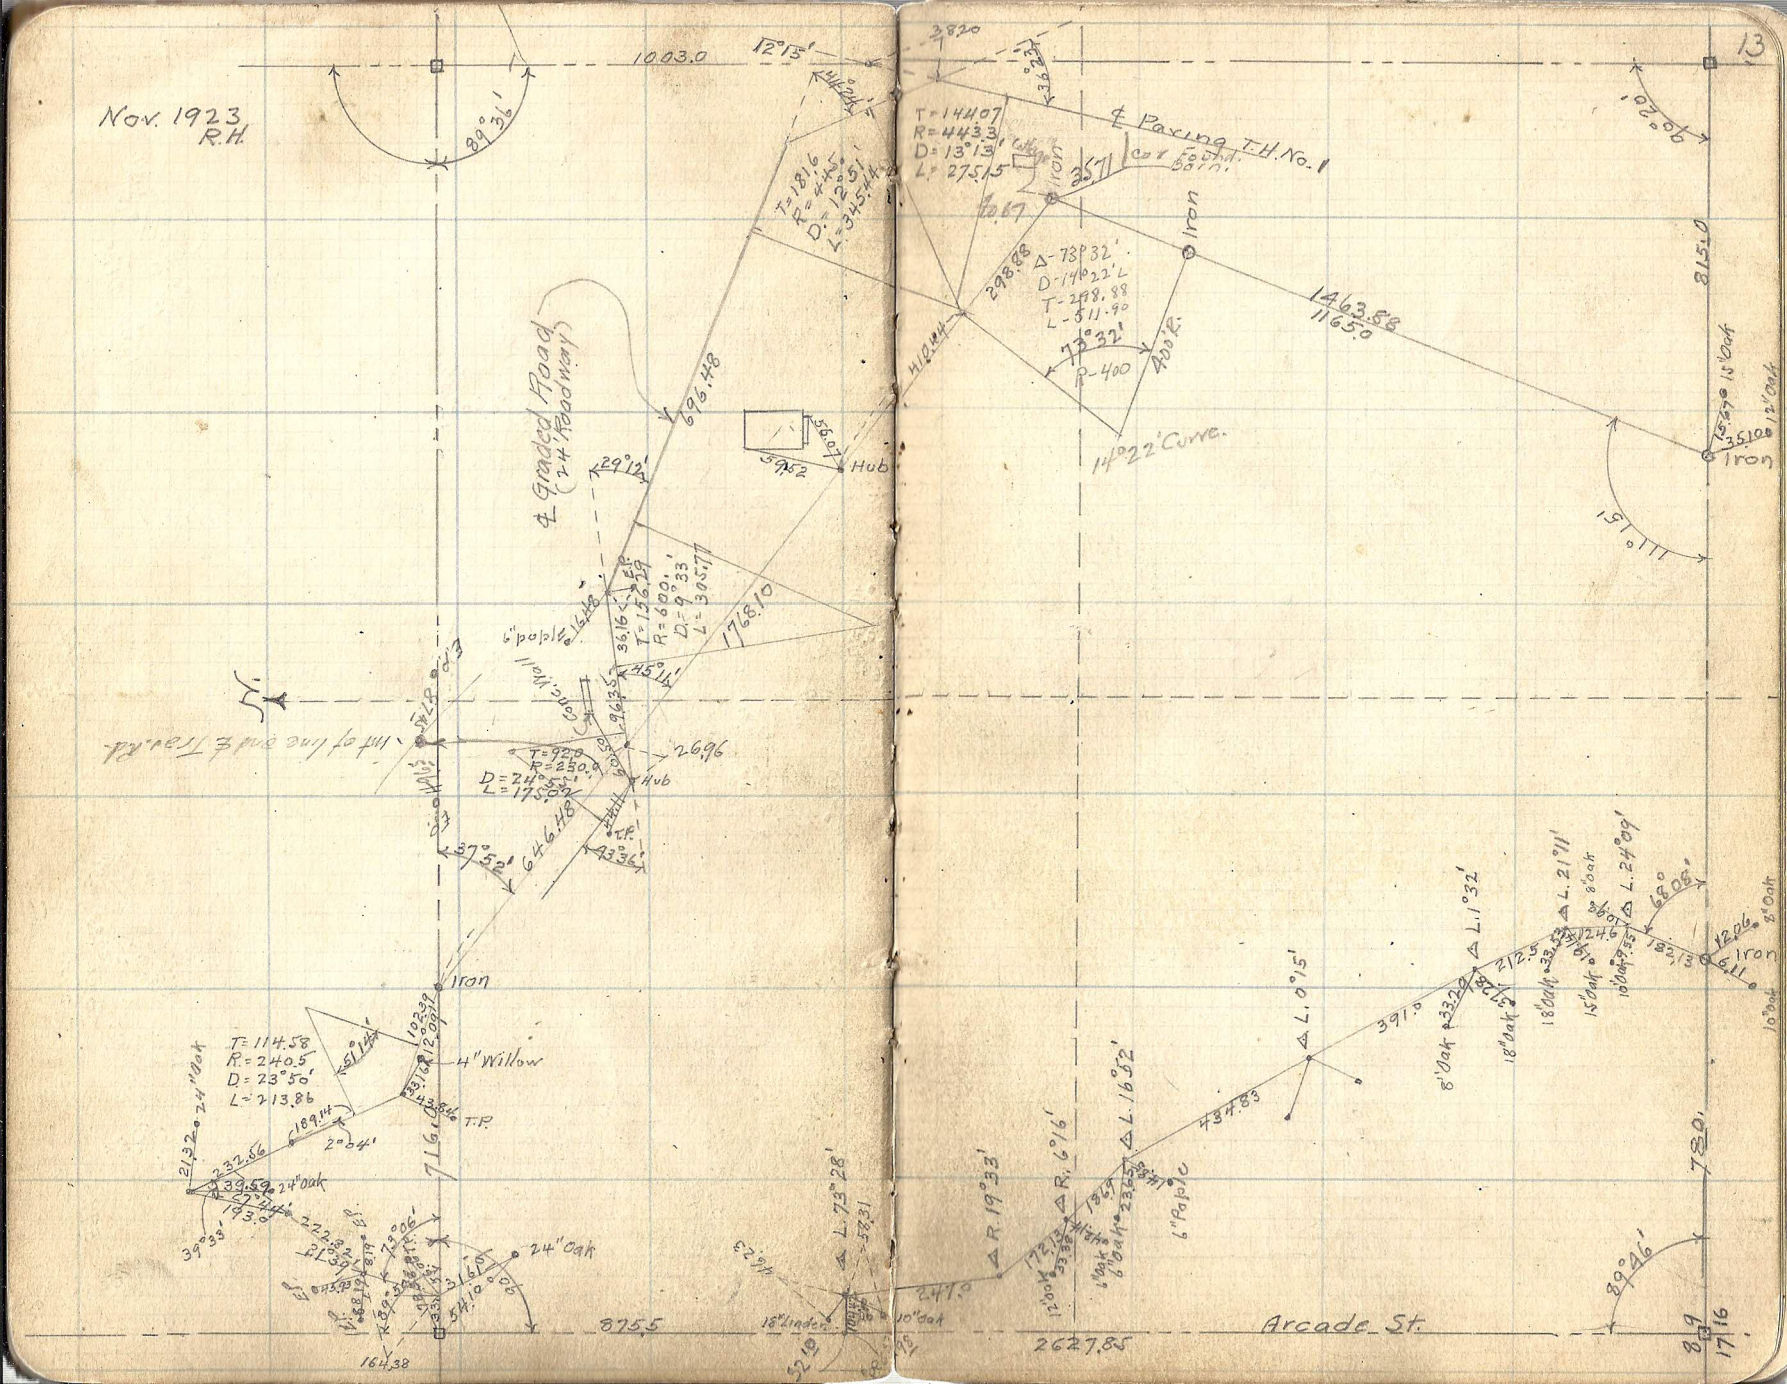
Nov. 1923
R.H.
1003.0
12°15'
89°36'
T=144.07
R=443.3
D=13°13'
L=275.15
℄ Paving T.H. No. 1
Cor. Found. Barn.
Iron
Iron
Iron
Iron
Δ-73°32'
D-14°22' L
T-298.88
L-511.90
73°32'
R-400
400' R.
14°22' Curve.
1463.88
1165.0
815.0
111°15'
T=181.6
R=445.
D=12°51'
L=345.44
696.48
℄ Graded Road
(24' Roadway)
29°12'
Hub
1768.10
T=156.29
R=600.
D=9°33'
L=305.77
45°11'
Conc. Wall
Int. of line and ℄ Trav. Rd.
T=92.0
R=230.0
D=24°55'
L=175.02
26.96
Hub
T.P.
37°52'
646.48
Iron
T=114.58
R=240.5
D=23°50'
L=213.86
4" Willow
T.P.
24" Oak
24" Oak
24" Oak
39°33'
716.0
164.38
875.5
Δ L. 73°28'
18" Linden
10" Oak
247.0
Δ R. 19°33'
Δ R. 6°16'
Δ L. 16°52'
6" Pop'c
434.83
Δ L. 0°15'
391.0
Δ L. 1°32'
Δ L. 21°11'
Δ L. 24°09'
68°08'
Iron
780.
89°46'
Arcade St.
2627.85