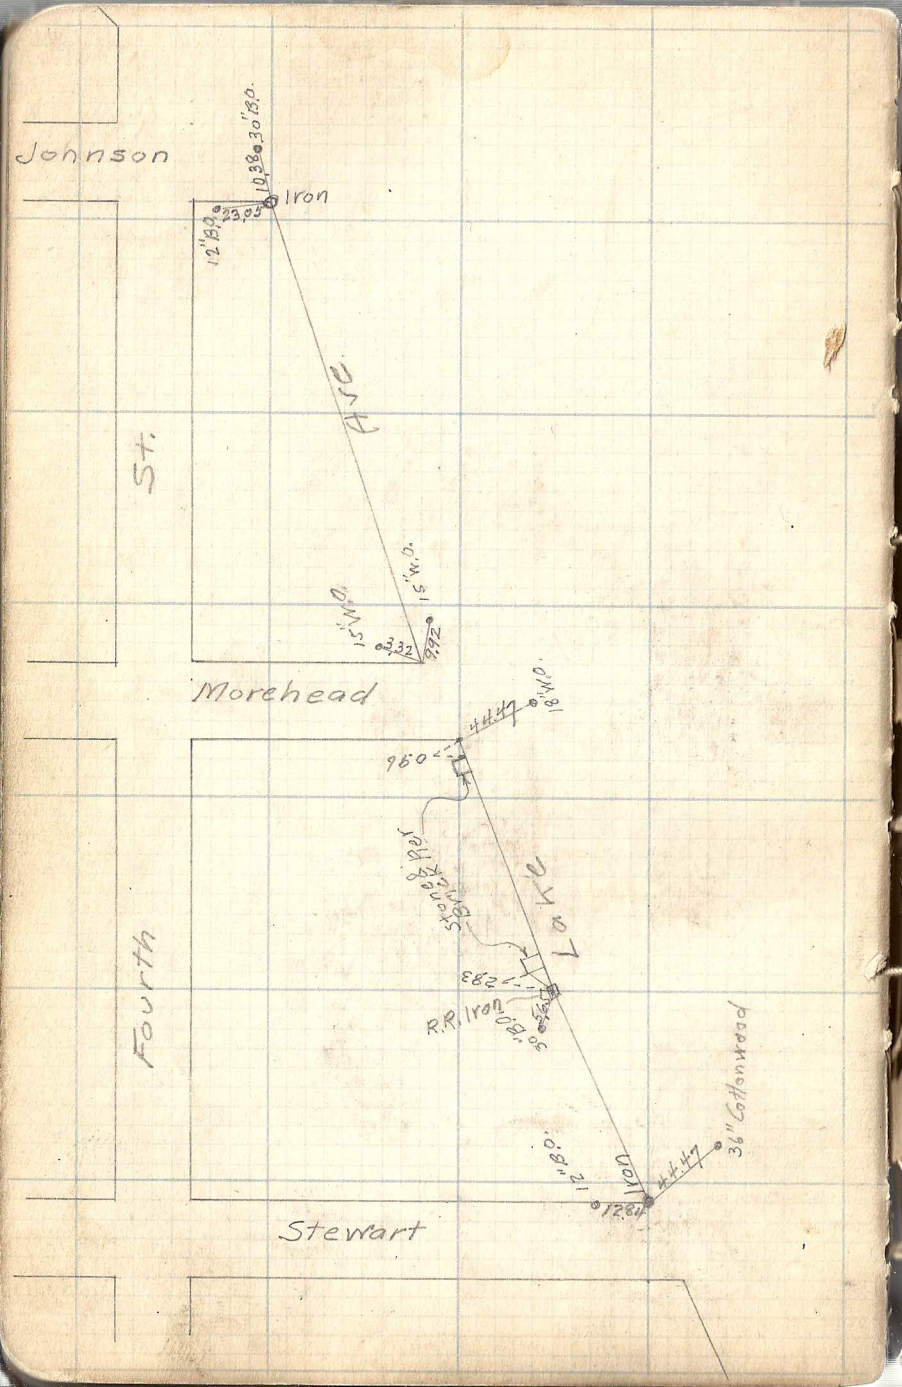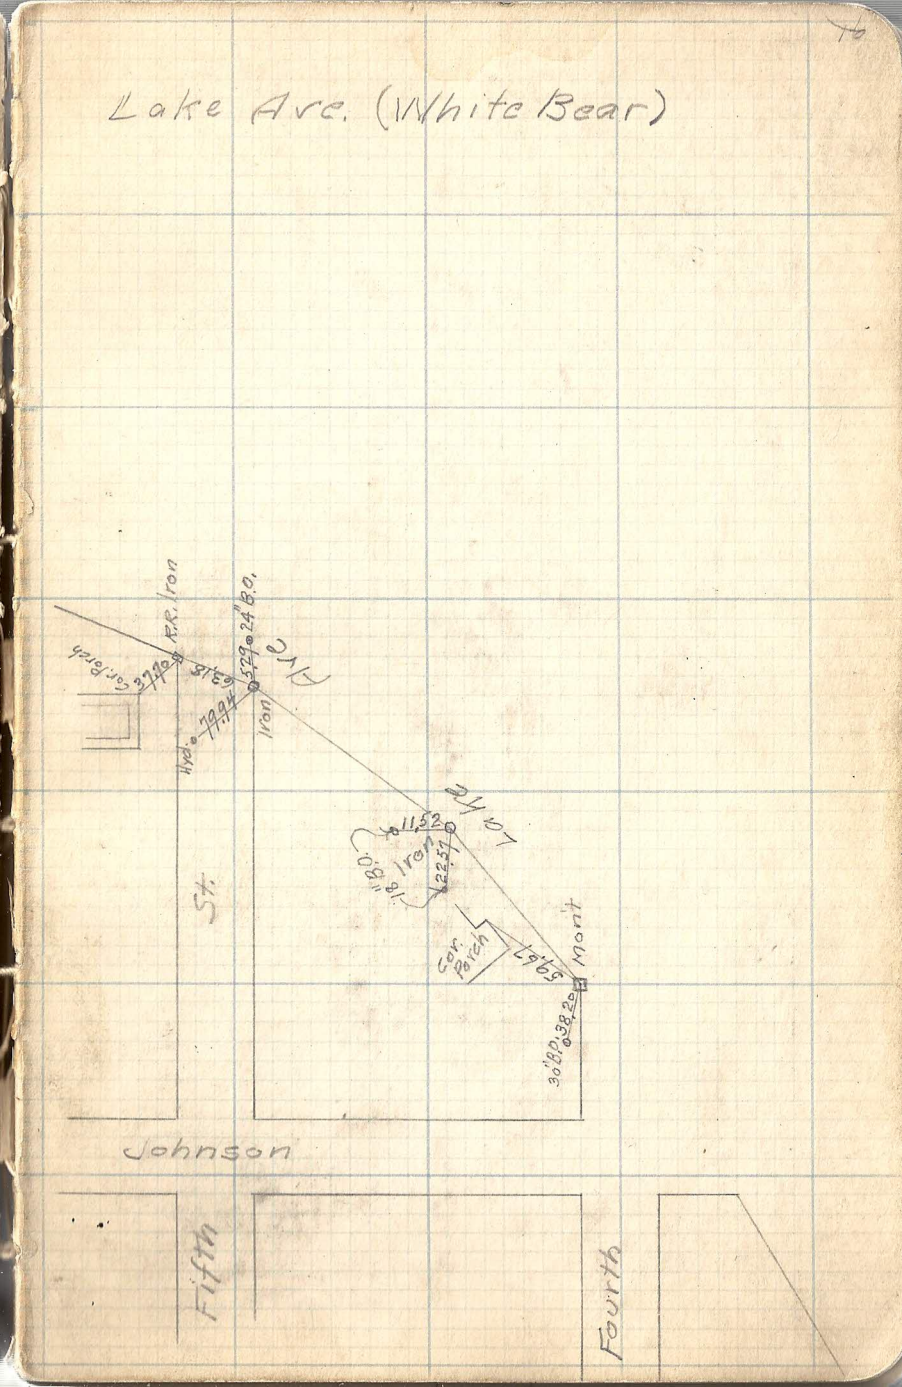Lake Ave. (White Bear)