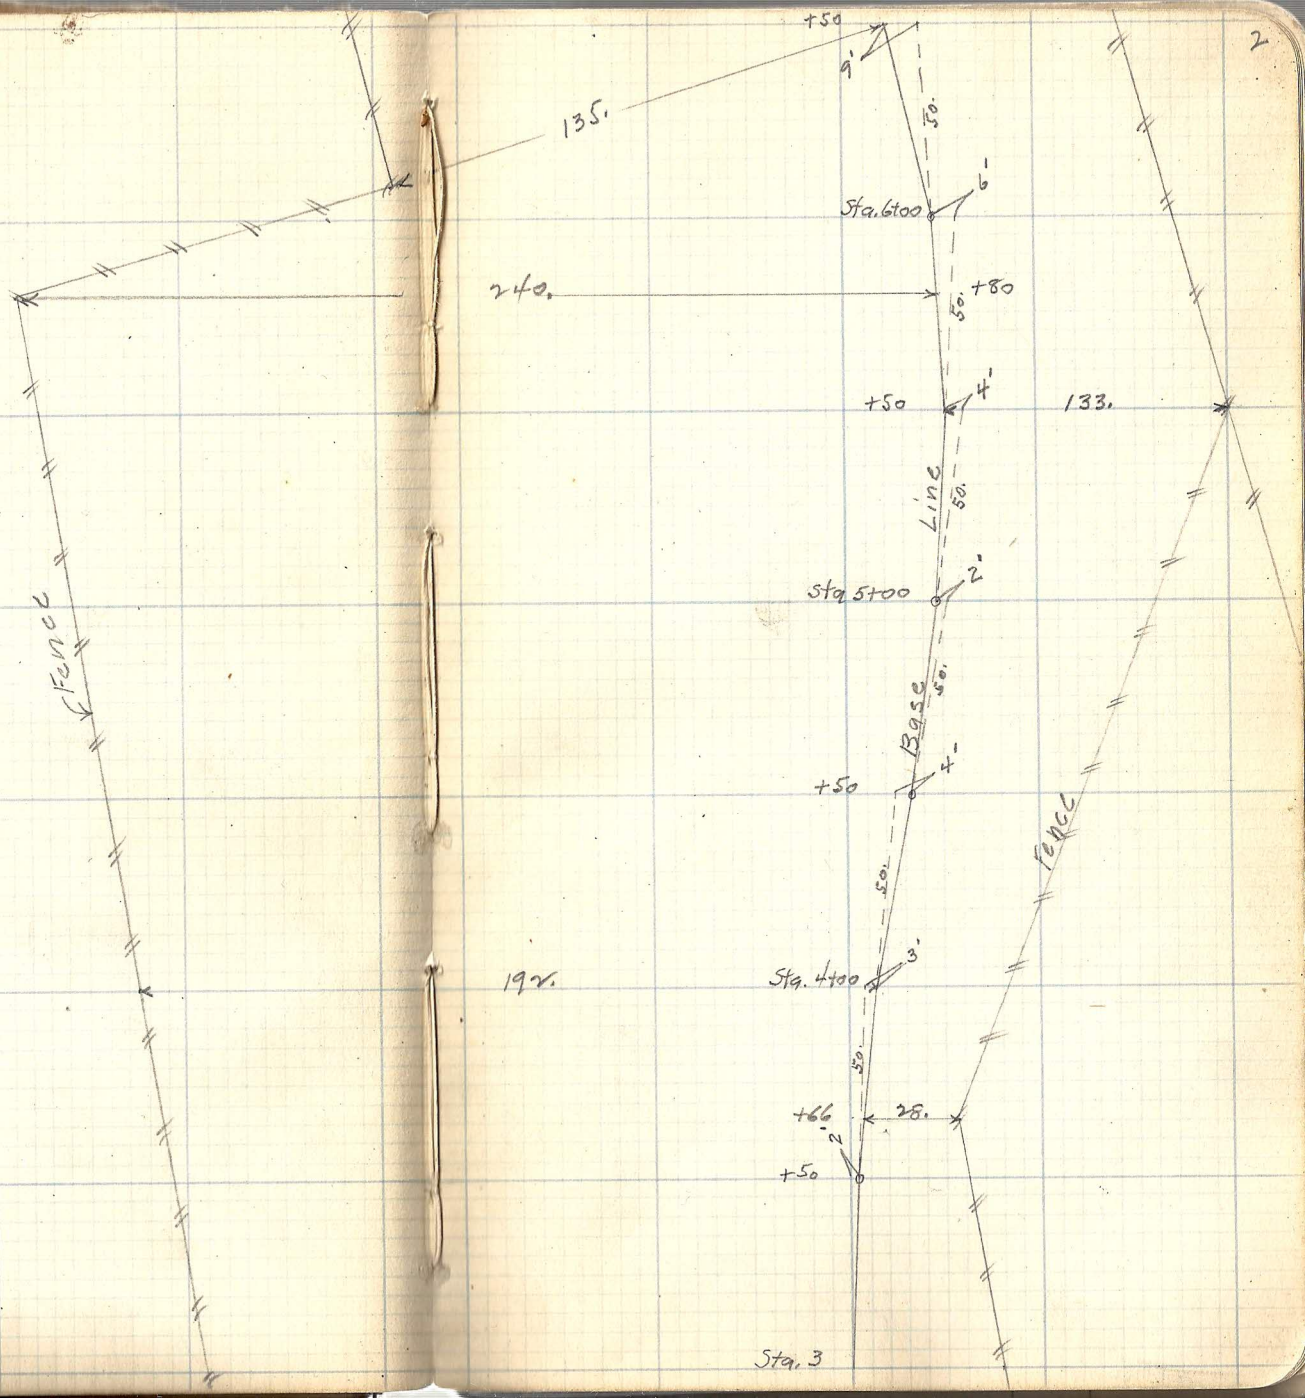
+50
9'
135.
50.
Sta. 6+00
6'
240.
+80
50.
+50
4'
133.
Line
50.
Sta. 5+00
2'
50.
Base
+50
4'
50.
Fence
Fence
19 r.
Sta. 4+00
3'
50.
+66
28.
2
+50
Sta. 3