


South Line Sec. 24-30-22
← 262998 to South 1/4 East Sec 24
(Cen. Bellaire Ave Page 24)

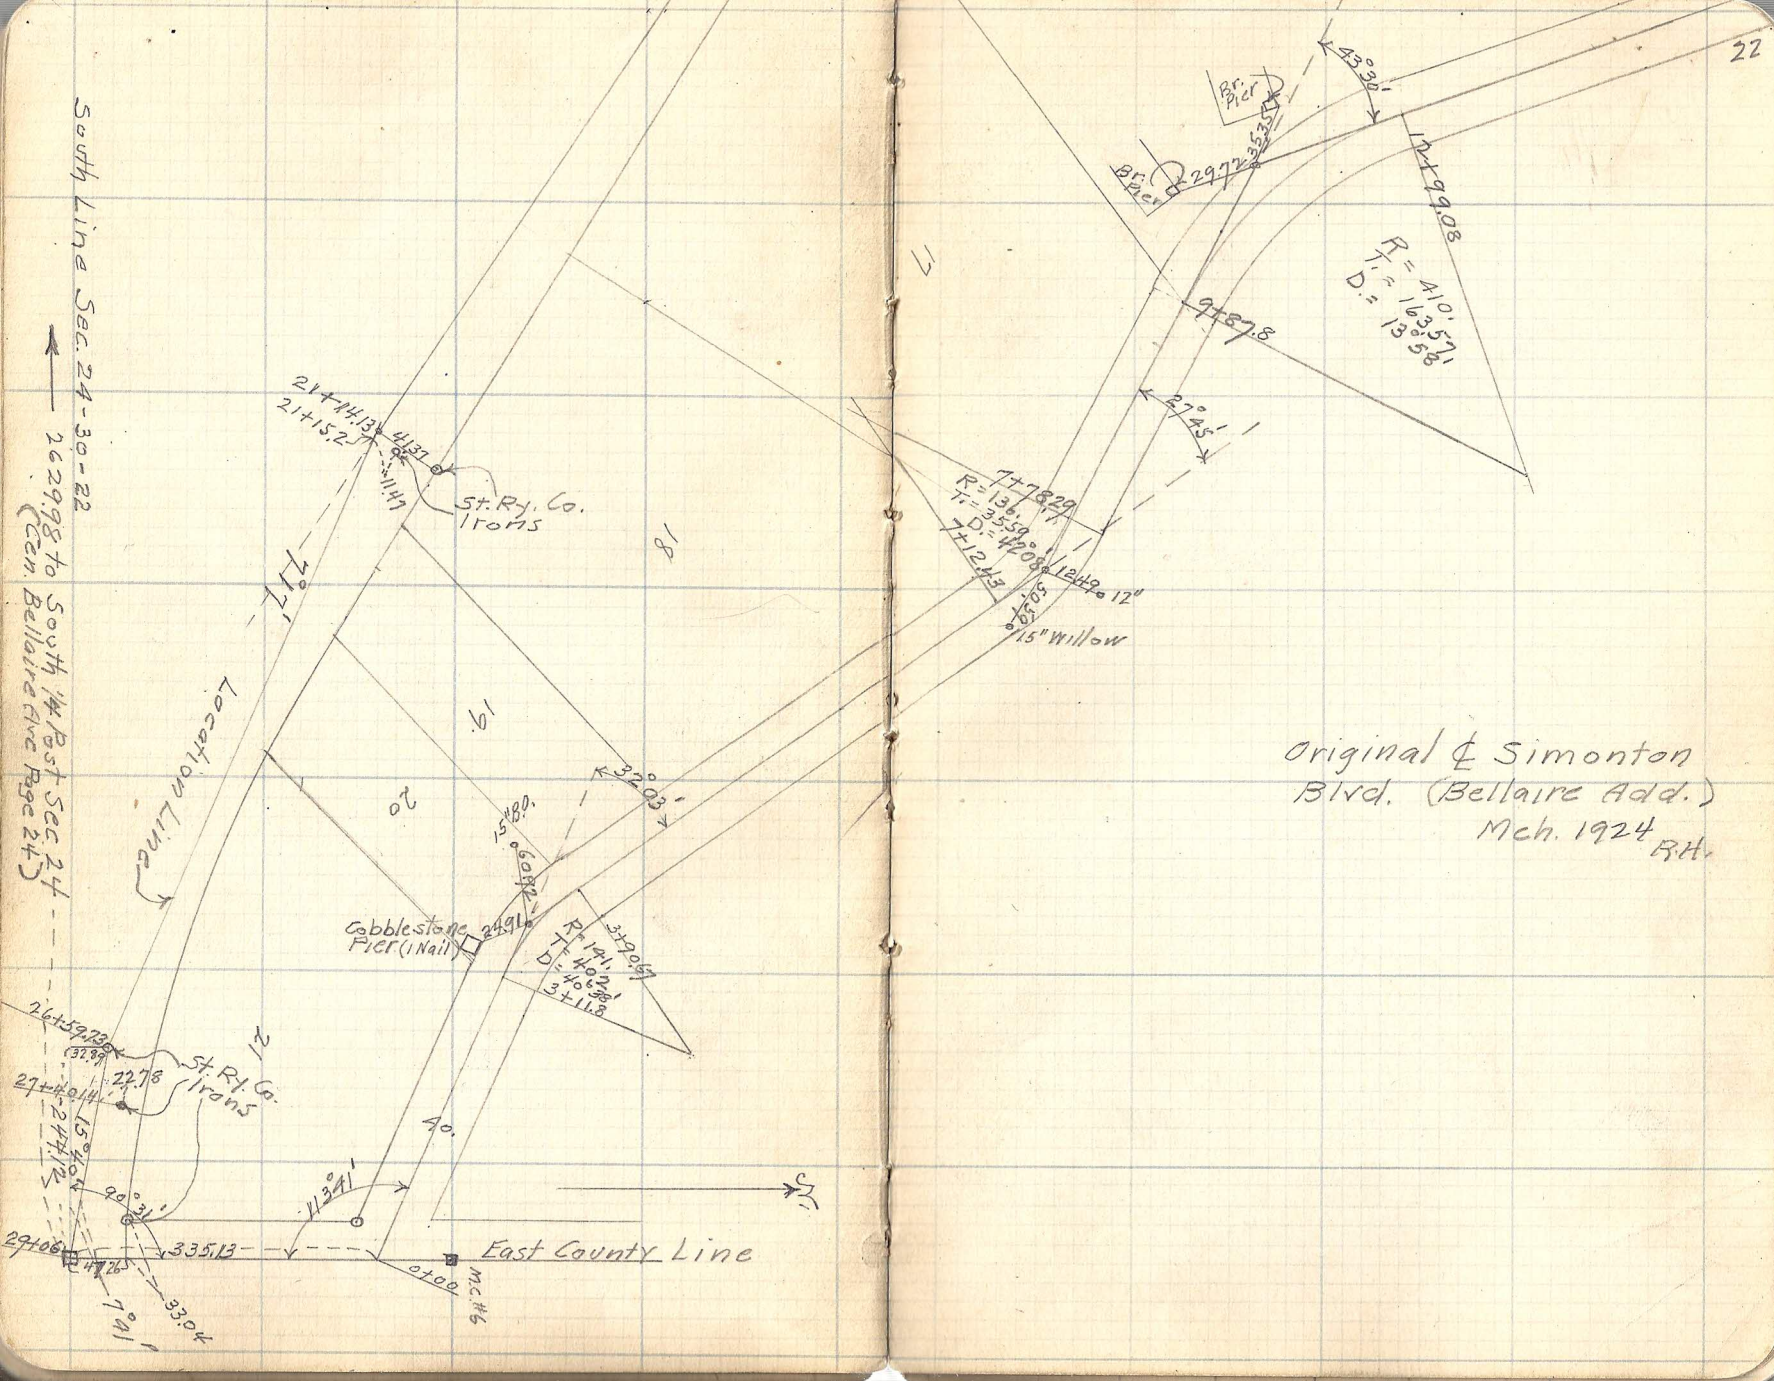

original of Simonton
Blvd. (Bellaire Add.)
Mch. 1924 BH