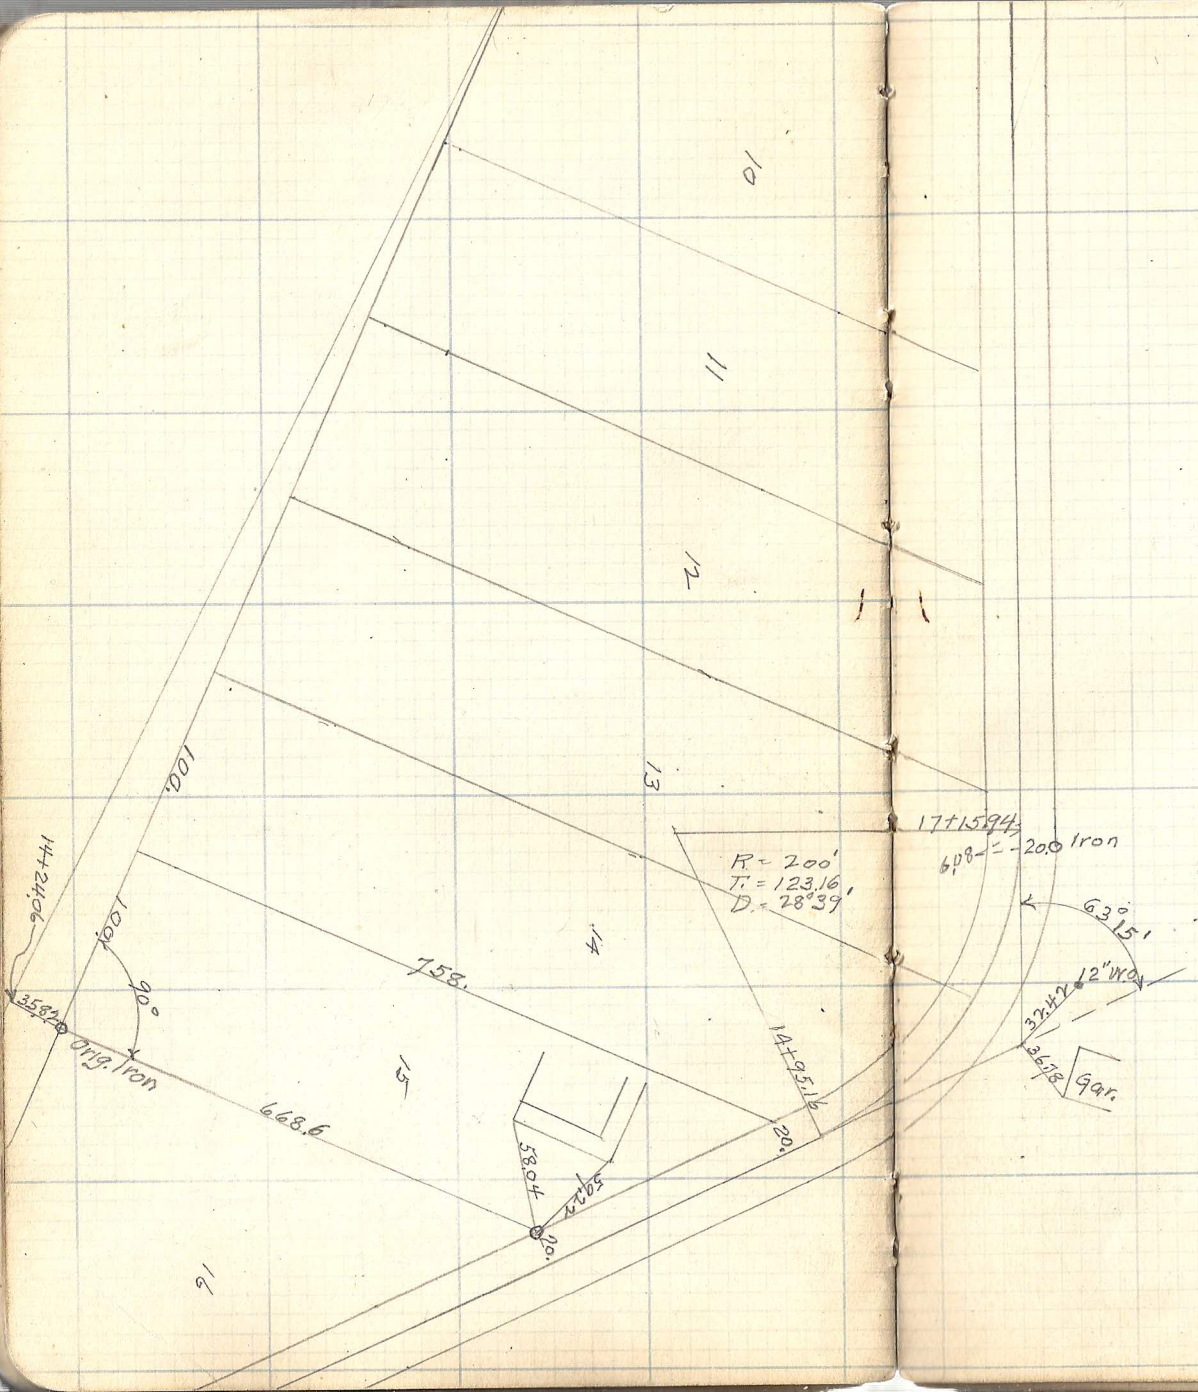
10
11
12
13
14
15
16
17+15.94
6.08
20.0 Iron
R = 200'
T. = 123.16'
D. = 28°39'
63°15'
12" W.O.
32.42
36.78
Gar.
14+95.16
20.
758.
668.6
100.
100.
90°
14+24.06
35.82
Orig. Iron
58.04
59.22
20.