


5°14'
T.P. 3364
48+29.80
2173 T.P.

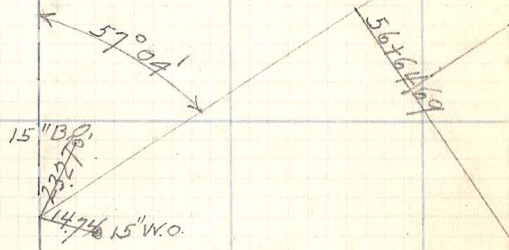

R. = 540.
T. = 293.40
Deg. = 10°36'

51+26.86