


The S.E. 1/4 of the S.W. 1/4
 Sec. 10, T. 30 R. 23 &
 The West 15 Acres thereof
 Dec. 12-24
 P.H.

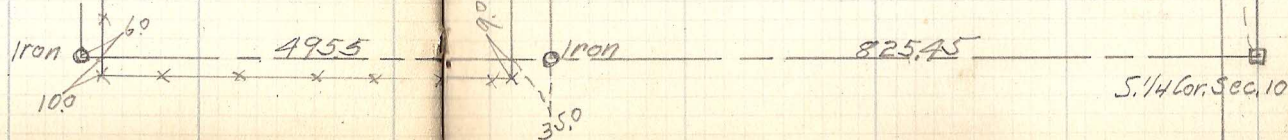

1318.93
 Hamline Ave.

S. 1/4 Cor. Sec. 10