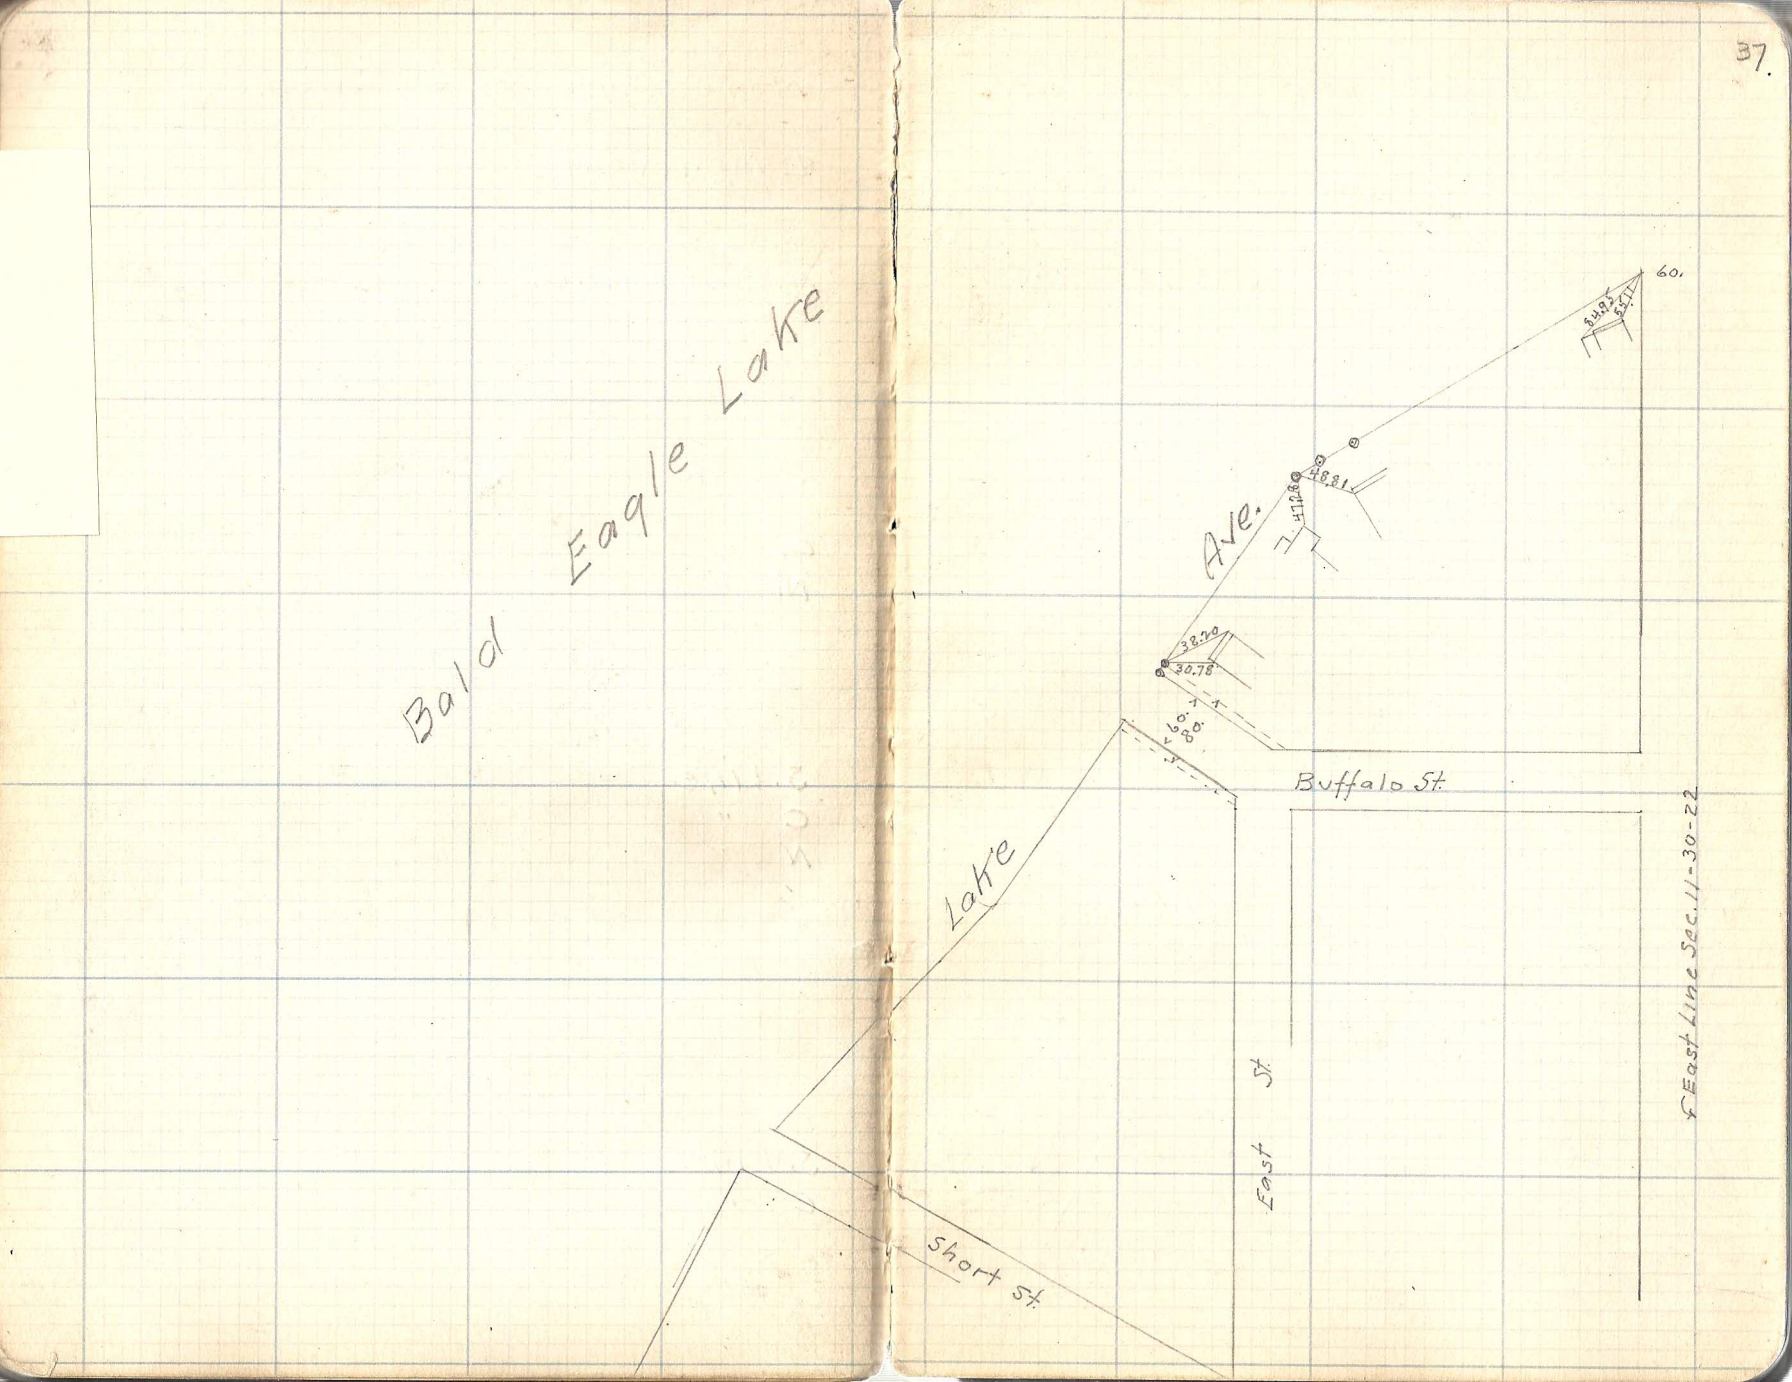
Bald Eagle Lake
Ave.
60.
38.70
30.78
Buffalo St.
Lake
East St.
Short St.
℄ East Line Sec. 11-30-22