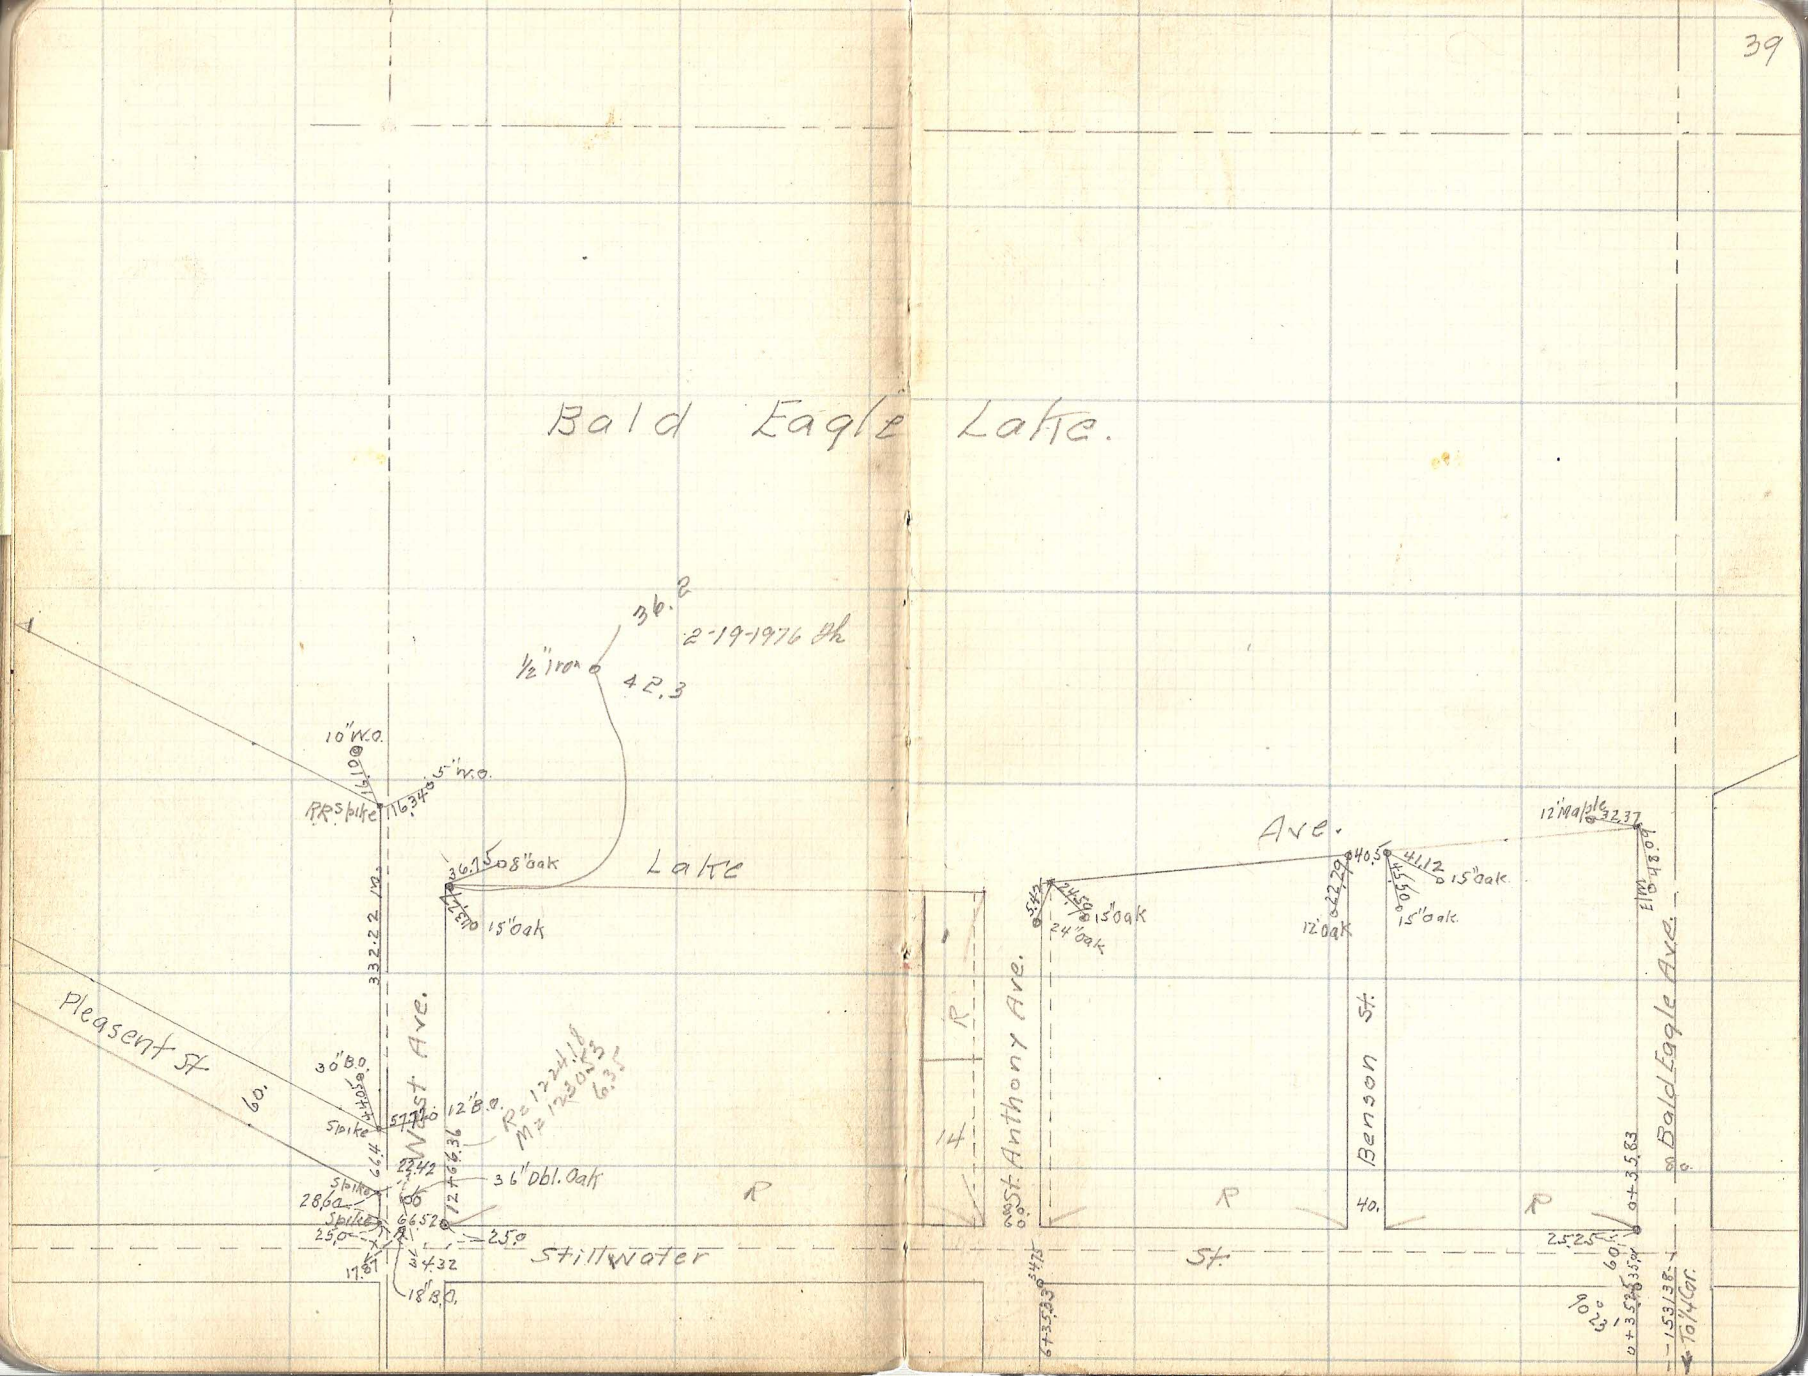
Bald Eagle Lake.
36.2
2-19-1976 Pk
½" iron
42.3
10" W.O.
RR Spike
11.6
3.4
5" W.O.
36.1
8" oak
Lake
12" elm
15" oak
332.2 M.
Pleasent St
60.
30" B.O.
5 Spike
57.7
12" B.O.
R=1224.18
M=1220.23
6.3
64.4
22.42
36" Dbl. Oak
28.6
Spike
66.52
25.0
Spike
17.87
24.32
18" B.O.
West Ave.
Stillwater
St.
R
14
St. Anthony Ave.
Ave.
40.5
24" oak
15" oak
12" oak
15" oak
12" Maple
32.37
48.09
Elm
Benson St.
40.
25.25
0+35.63
Bald Eagle Ave.
60.
0+35.83
0+35.38
153.38'
To W Cor.