

(Geo) = Georgi & Co. 2-1976

① E 1/4 Cor.

# CHECKING MON. ALONG N. LINE NE 1/4 Sec. 23-29-23


DALE

Brass Plug

ST.

C.I. at ARLINGTON

AVE.

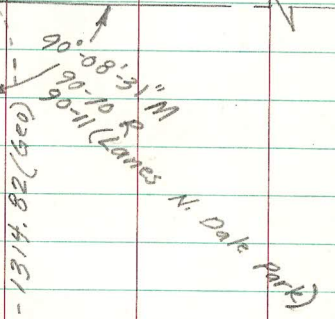

GROTTO ST

Brass Plug

(1930) 2628.18 → Stone to Stone (St. Paul)  
(1939) 2628.17

179° 58' 38" (Geo)

1313.57 (Geo)  
1313.68 (Plot Resurvey Com)

LARPEUR

Brass Plug

Stone at Grotto St. in 1939 at split (found by St. Paul)



March & April, 1976

1

R = Record on Section Maps  
Ties from St. Paul when stone existed at Larp. Av. & Dale St.

Spk. in joint of curb

HOYT

DALE


ARLINGTON

ST.

single  
V = 89-121-42  
S = 1119.120  
D = 1119.671

1512.00 St Paul -  
to Stone at Larp. Av.  
1512.343 M  
to brass plug

Brass Plug (3-1976)  
LARPEUR

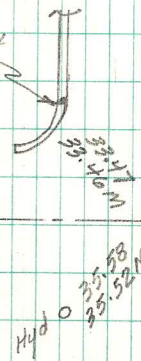

Found P.K.

triple  
V = 90-08-57 --  
S = 2632.090  
D = 2632.014

2631.44 St. Paul  
2631.07 R

