


(Cont.)

14

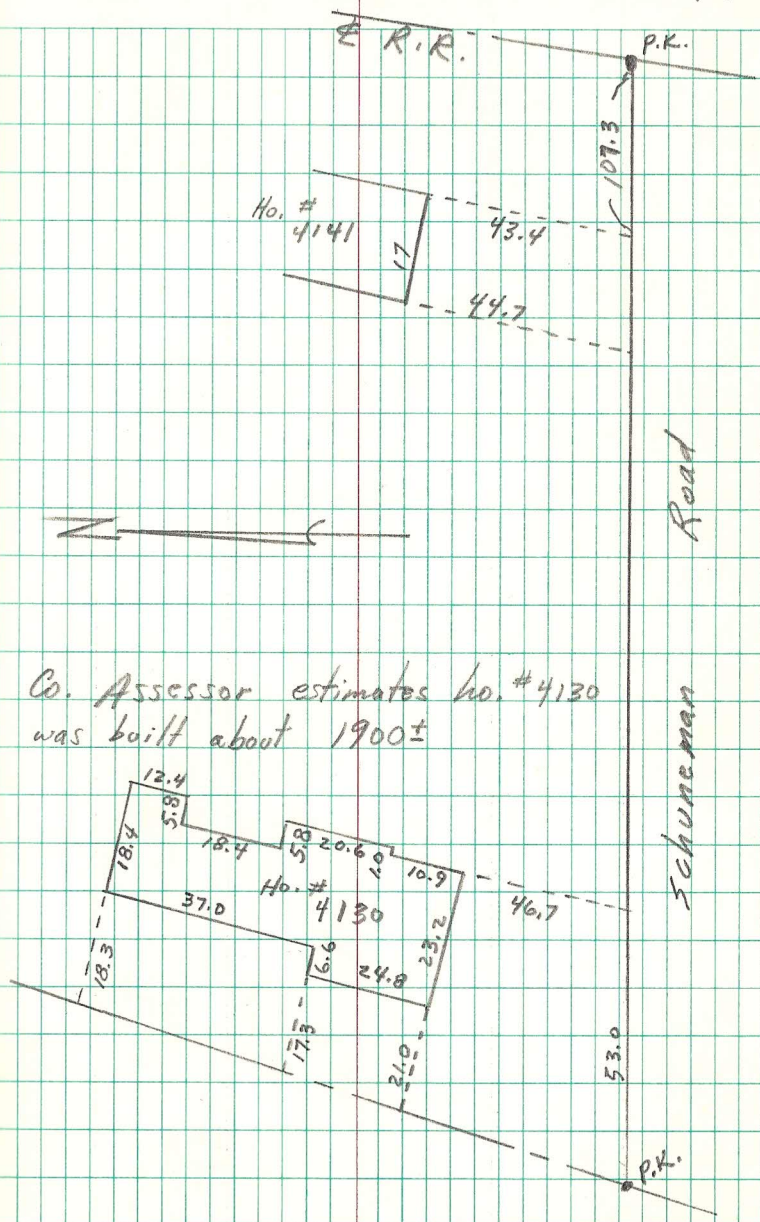

Co. Assessor estimates ho. #4130  
was built about 1900±