OPEN SPACE SURVEY
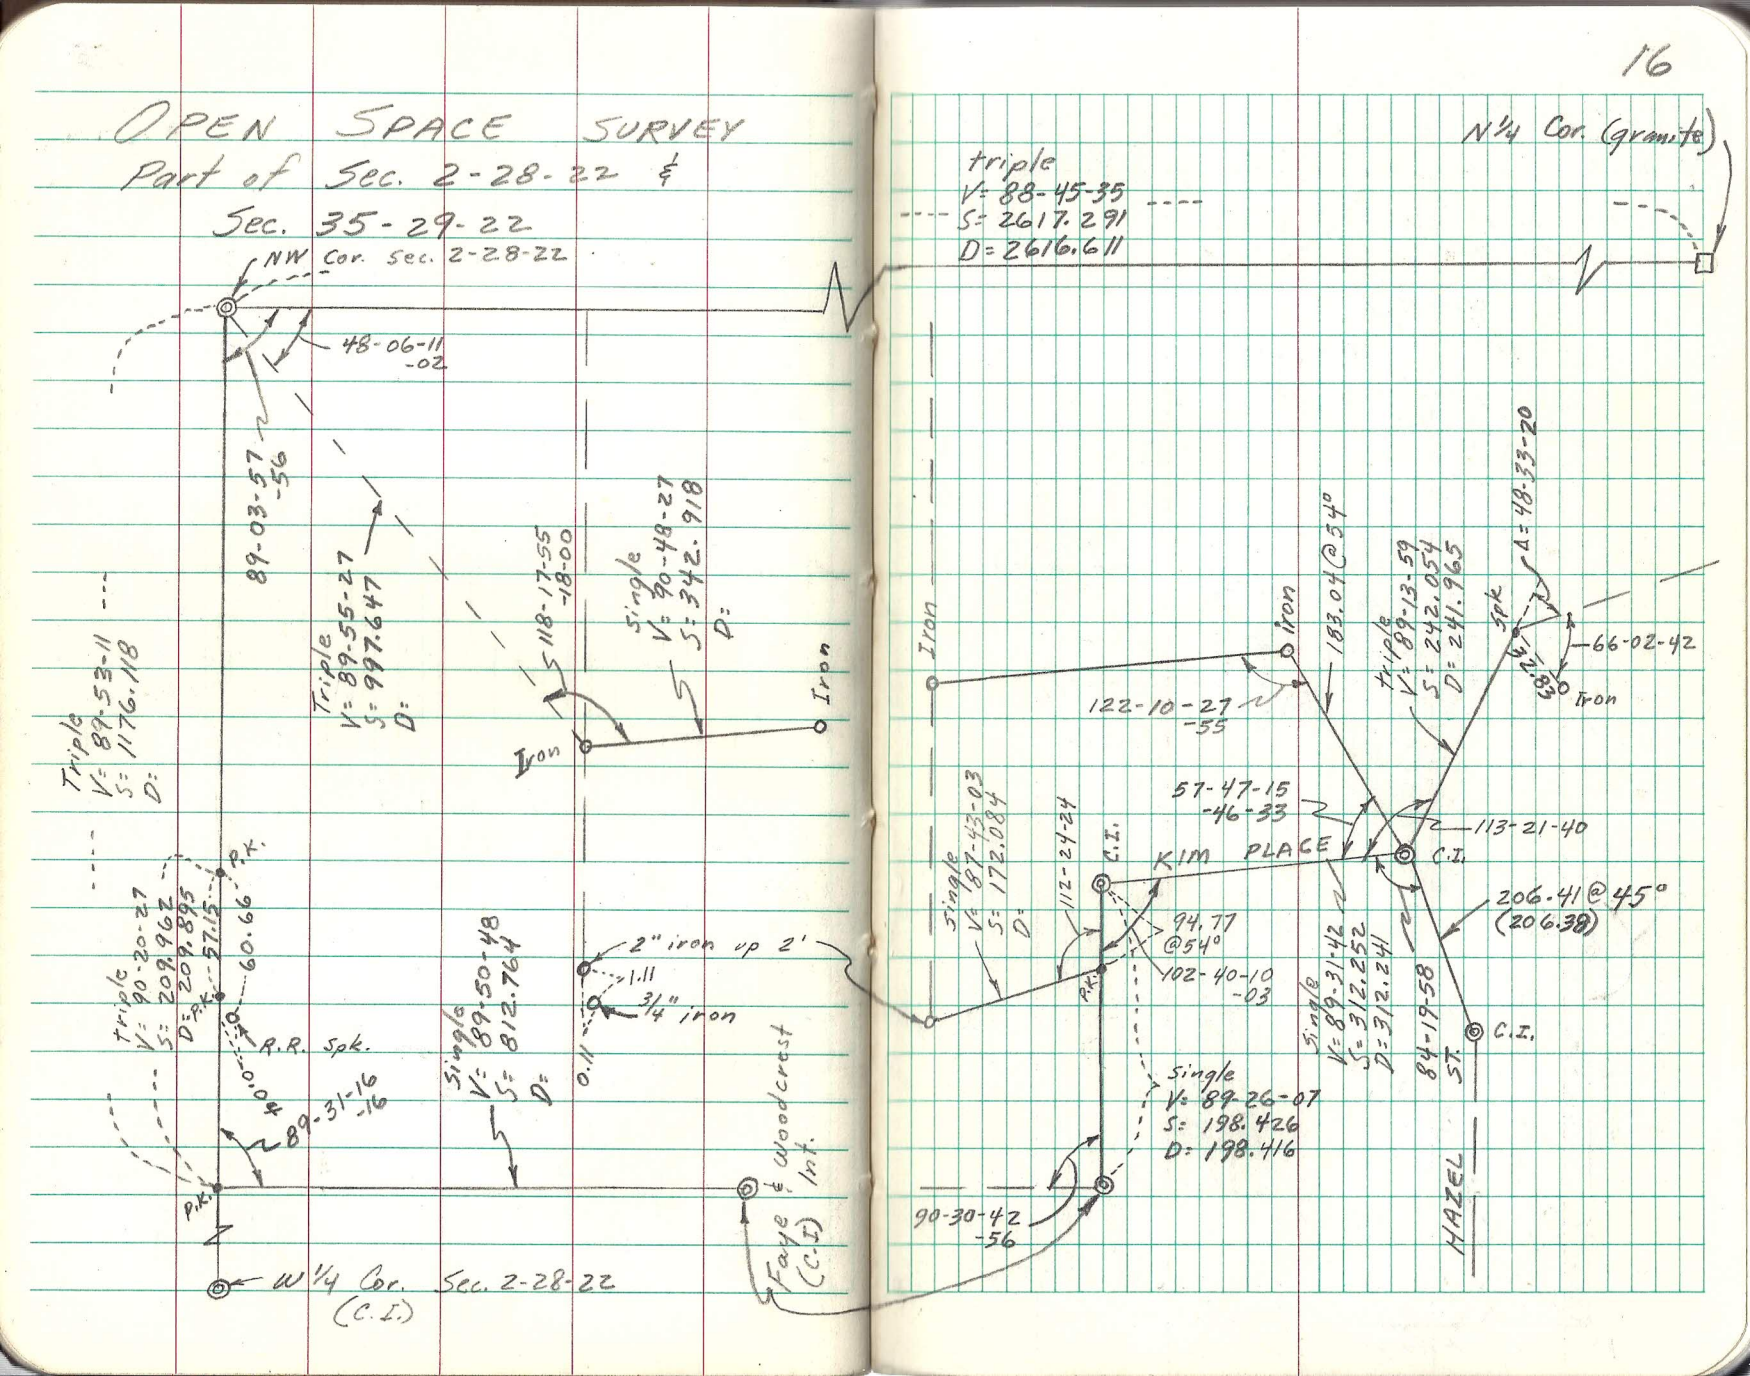
Part of Sec. 2-28-22 & Sec. 35-29-22