


OPEN SPACE (POPLAR LAKE)

NE 1/4 Sec. 1-30-23

SEE

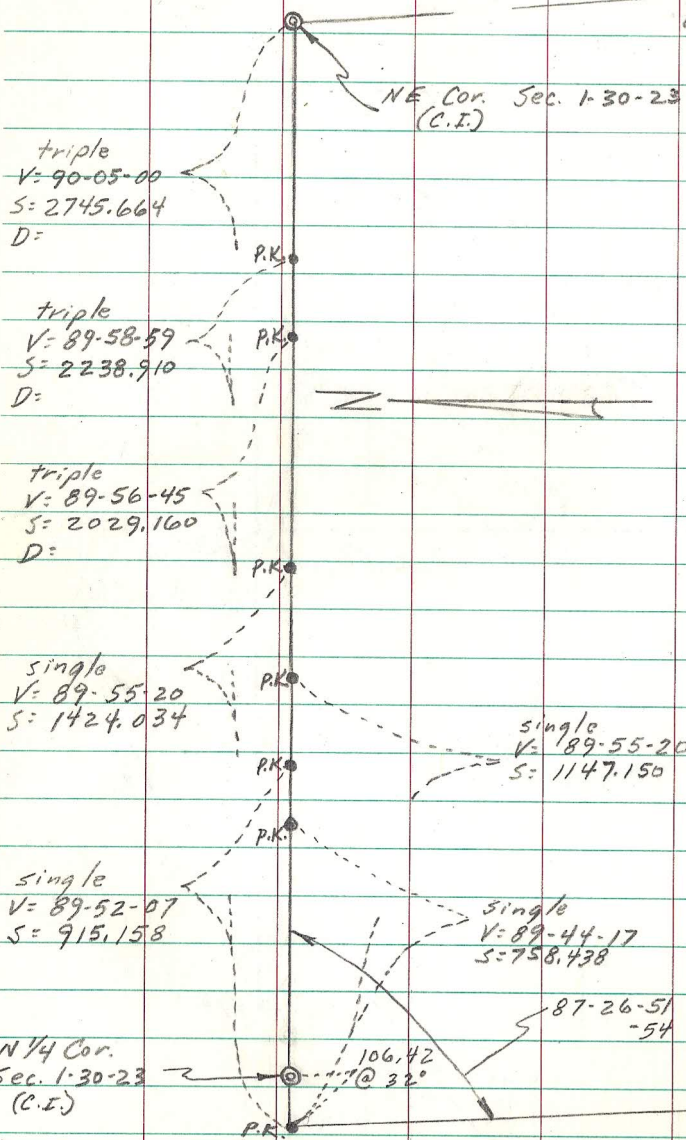

rev: R.M.
P.D.
P.K.

March 1979

25

PAGE 26

single
V: 90-00-47
S: 278.20
D: 278.20

single
V: 90-32-15
S: 591.13
D: 591.104

single
V: 90-49-05
S: 1004.81
D: 1004.707

triple
V: 90-24-30
S: 2629.573
D: 2639.439

Triple
V: 89-57-12
S: 3133.386
D: 3133.318

