


OPEN SPACE (POPLAR LAKE)

NW 1/4 Sec. 6, T30, R22

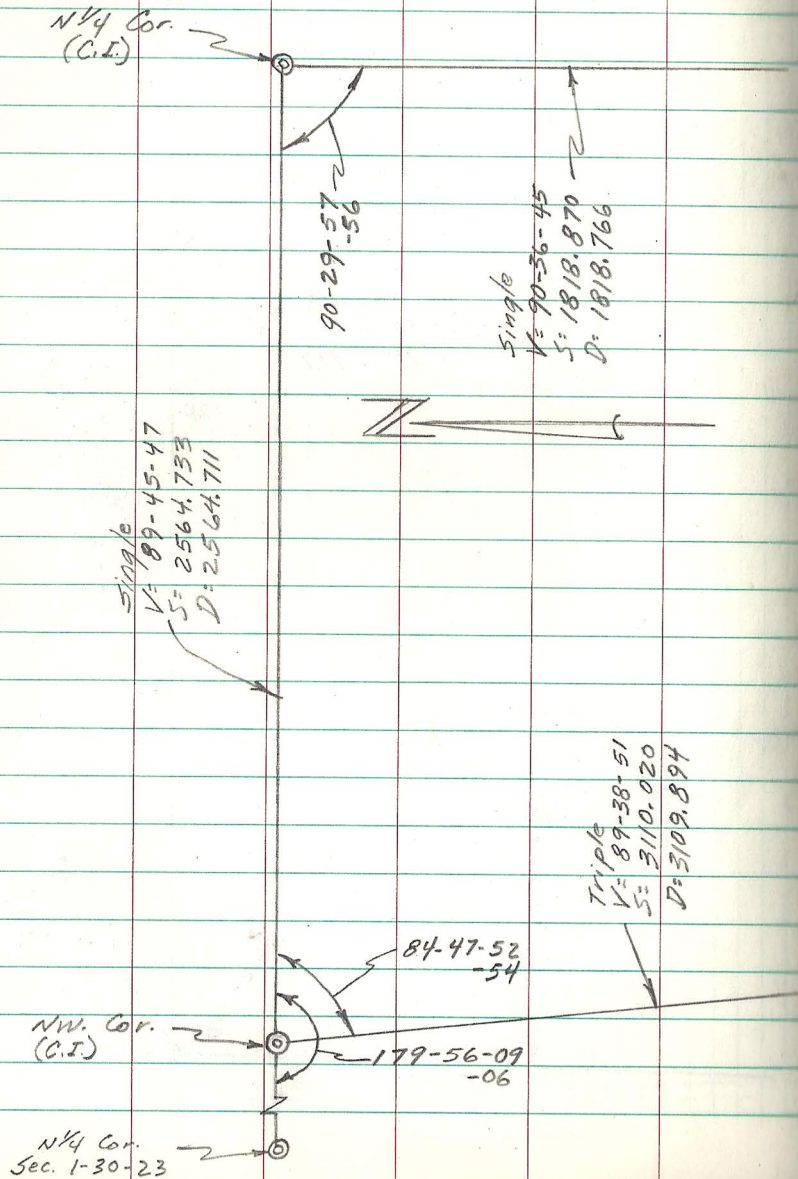

R.M.
P.D.
P.K.

March, 1979

26

