


OPEN SPACE (POPLAR LAKE)


NE 1/4 Sec. 6-30-22

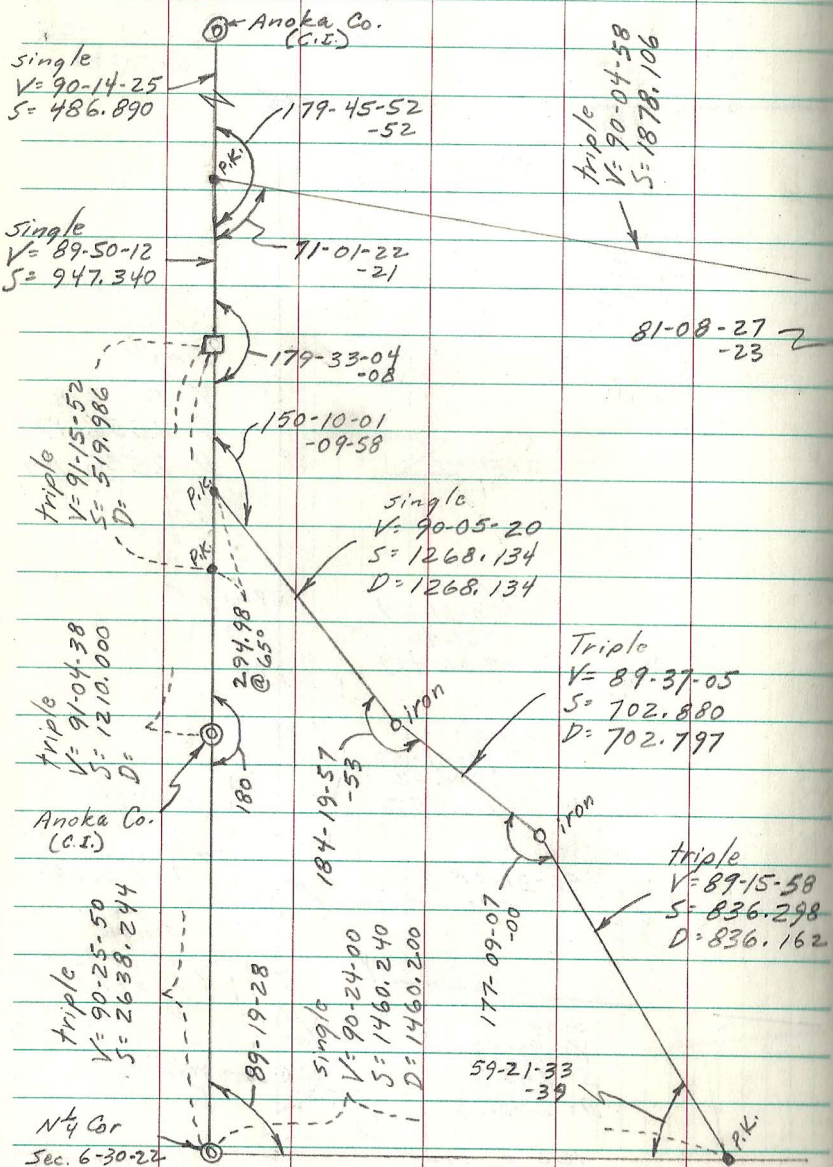

R.M.
R.D.
P.K.

1979

27

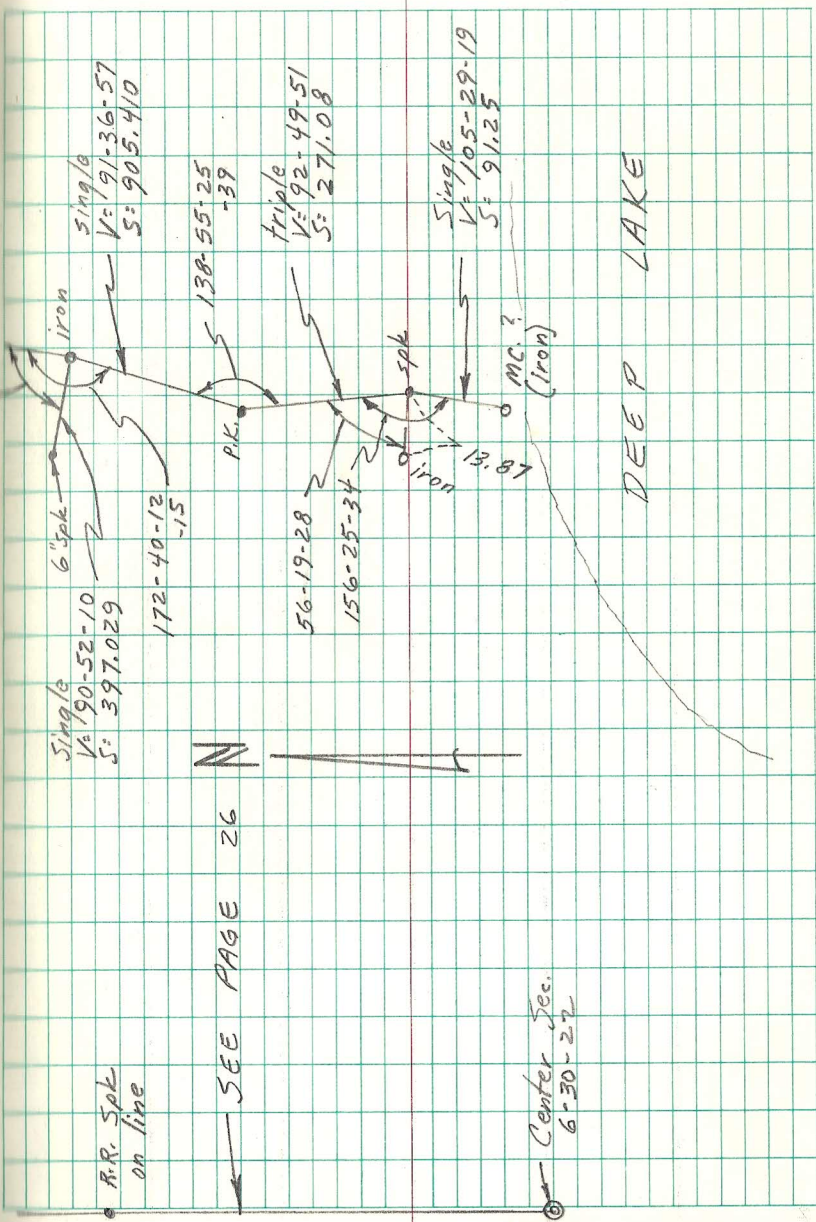

SEE PAGE 26

Center Sec.
6-30-22

DEEP LAKE