


OPEN SPACE (CARVER & FISH CREEK)

SECTION 24, T28, R22.

o = iron monument and cap

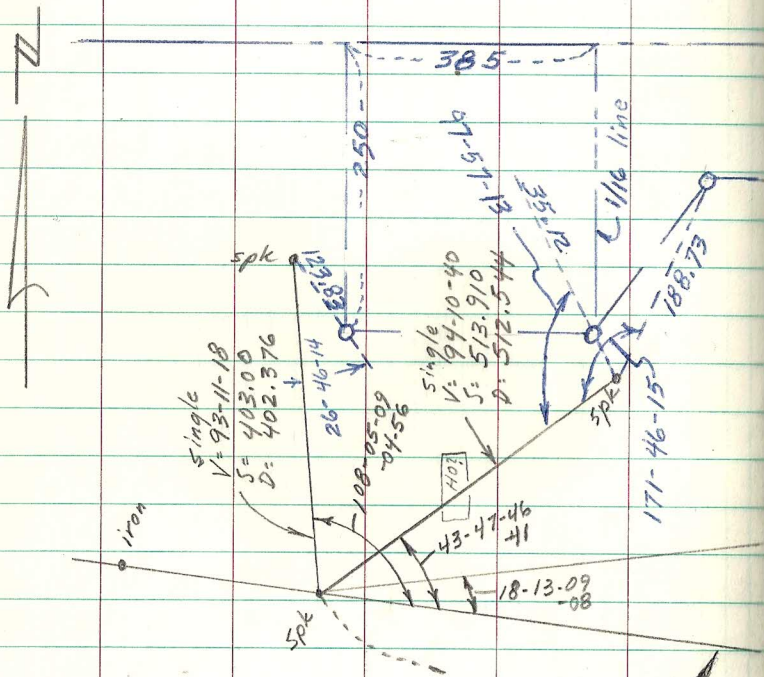

SEE SEC. 24, T28, R22 in
LITTLE CANADA & McLEAN
Page 16

See page 16, "LITTLE CANADA & McLEAN" for traverse work

N. line SW 1/4

