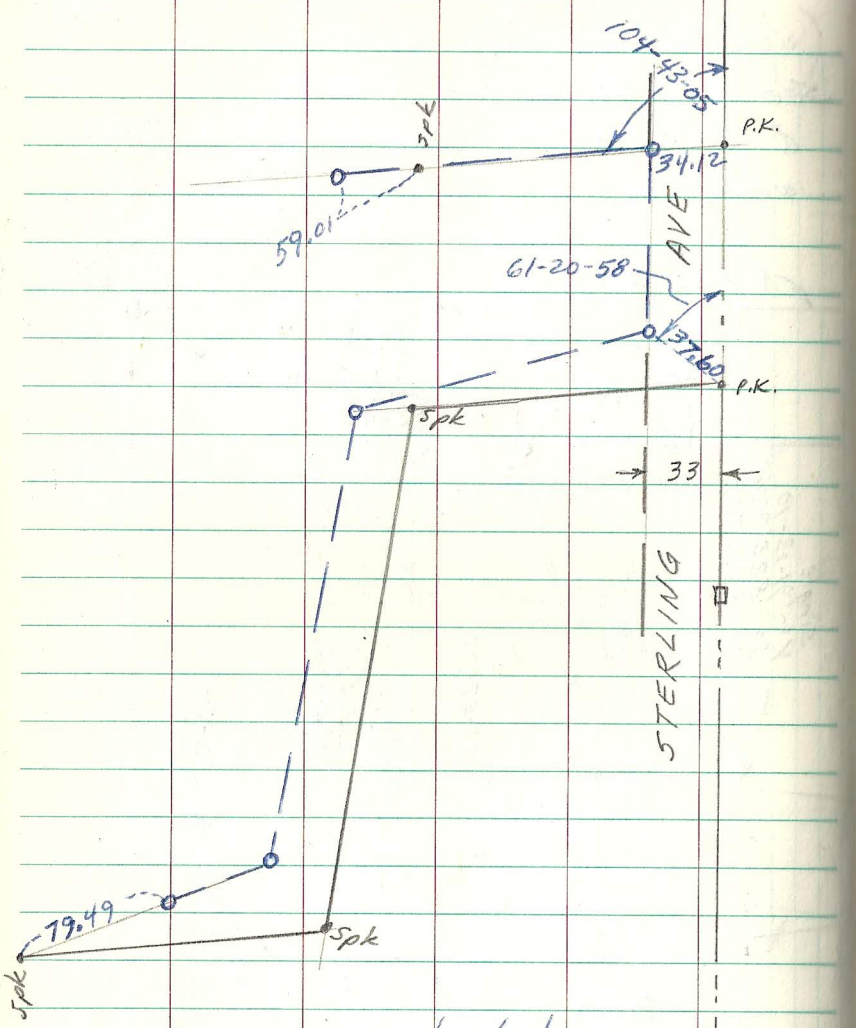

o = iron mon. and plastic cap
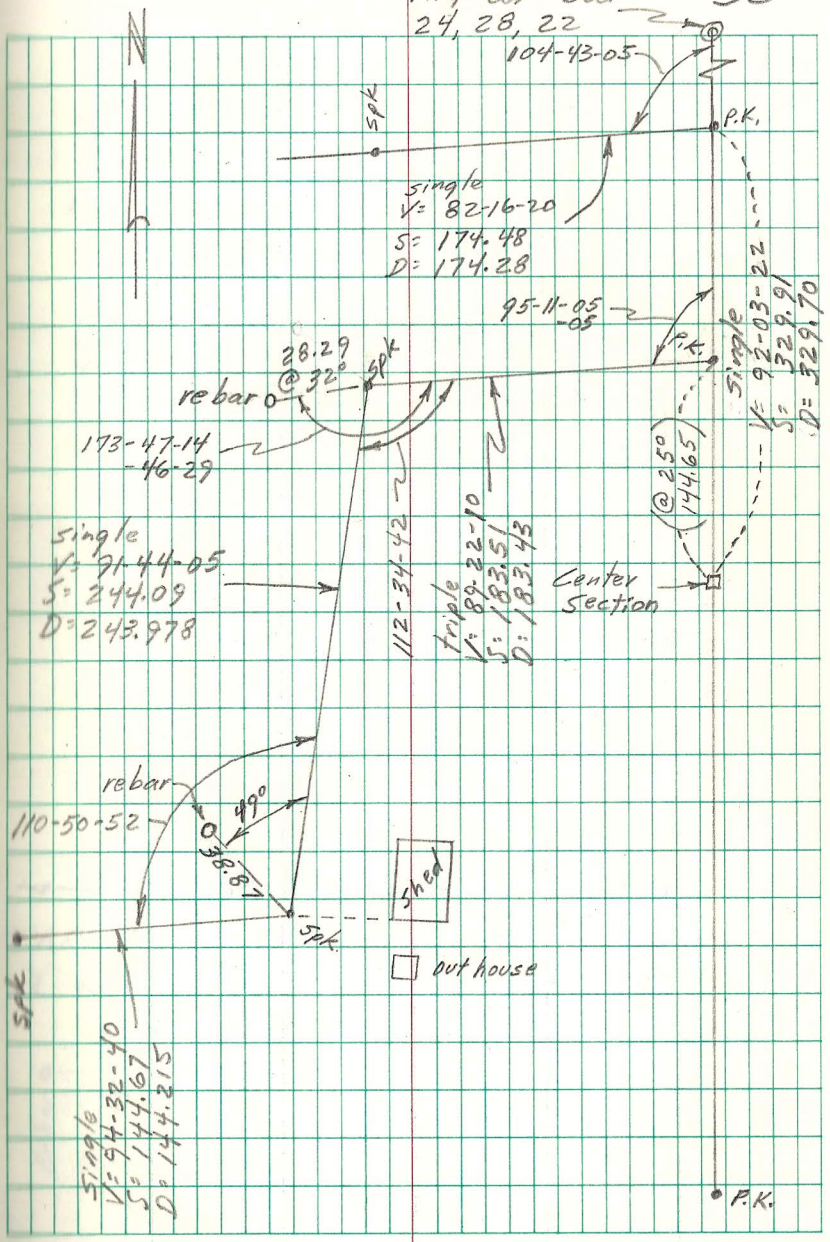
See page 16, "LITTLE CANADA & McLEAN" for traverse work.