


OPEN SPACE
SW 1/4 SEC. 3-30-23

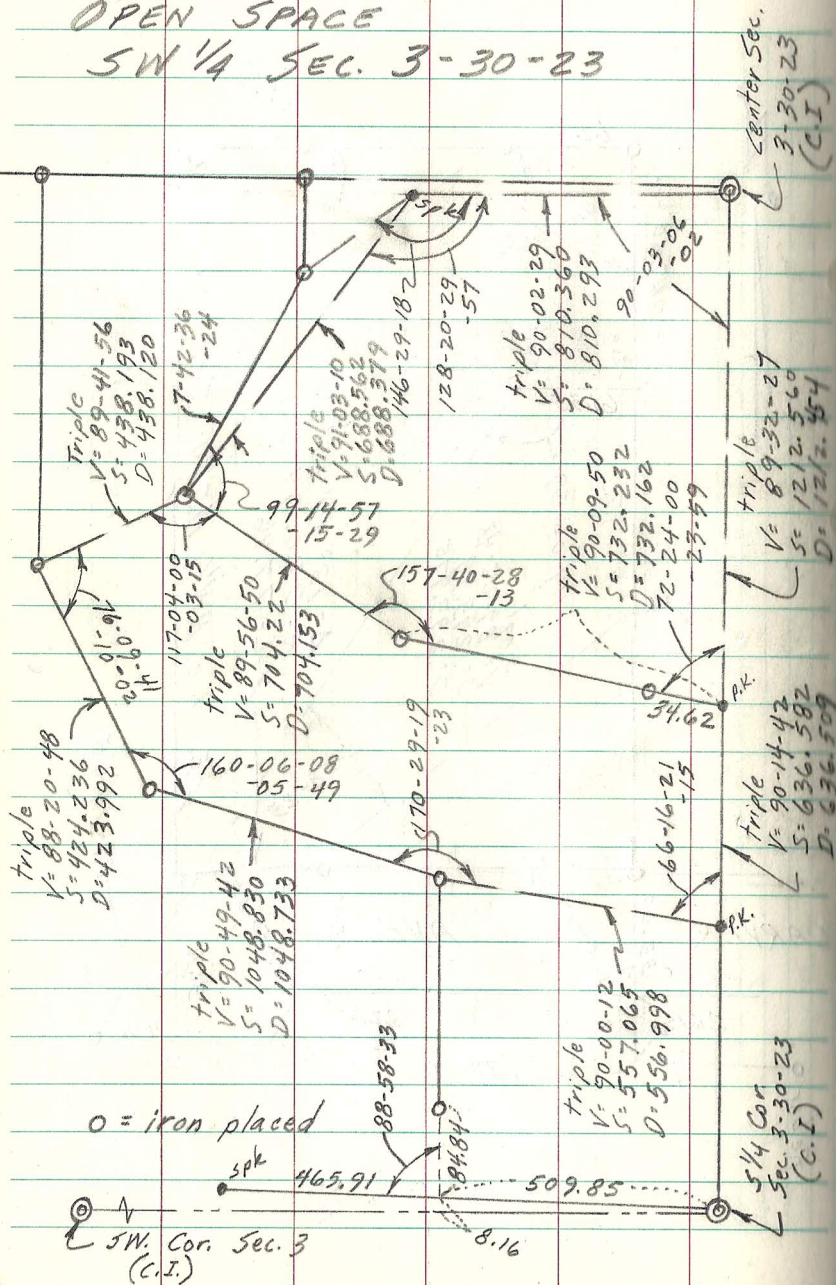

R.M.
M.F.
P.K.
R.W.

Fail, 1974

See "MOUNDVIEW," survey book, page 30
FOR SECTION TRAVERSE WORK.

