


# OPEN SPACE (KELLER GOLF COURSE)

SEC. 9-29-22

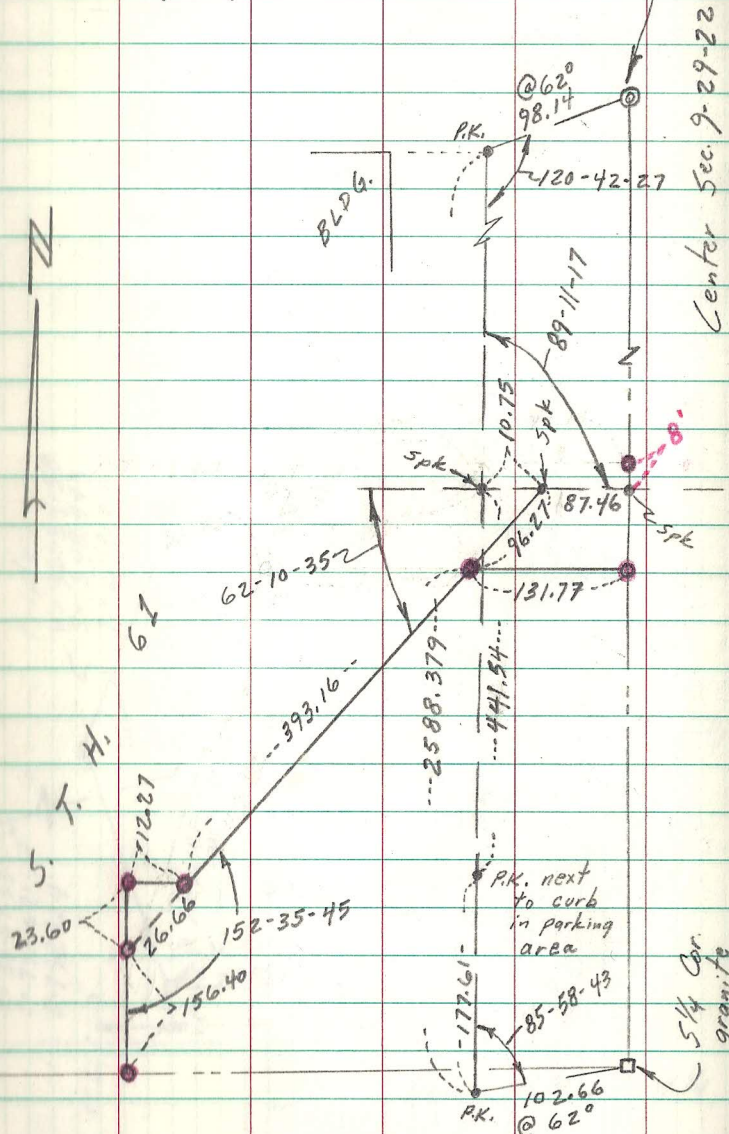


R.M.  
P.D.  
K.R.

Sept & Oct. 1980

37

o = 5/8" Rebar with plastic cap "RAMSEY COUNTY".

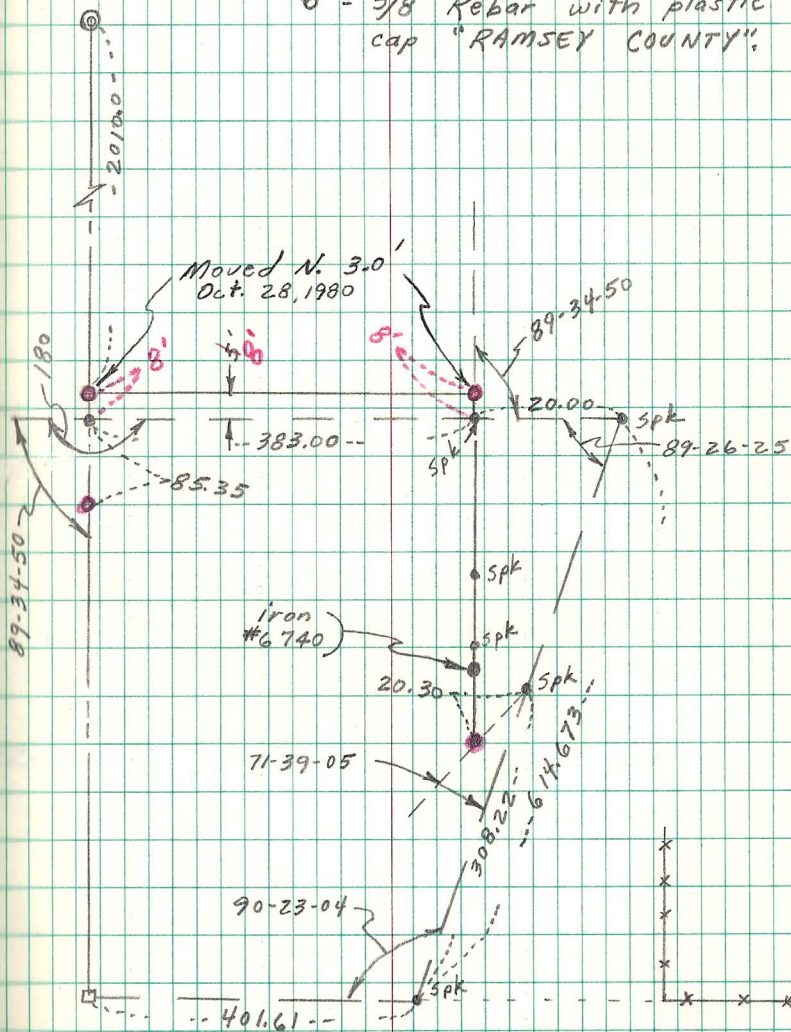

(OVER)