

CHECKING N $\frac{1}{4}$ Cor. SEC. 24-29-23

WESTERN AVE.

(ARLINGTON A. TO LARPENTEUR A.)


Notes from City of St. Paul
Book page
dated Nov. 1956. At that
time the N $\frac{1}{4}$ corner was a
large solid iron and the center
of section was a granite.

4

LARPENTEUR

AVE

0.23
N $\frac{1}{4}$ Cor.
(C.I.)

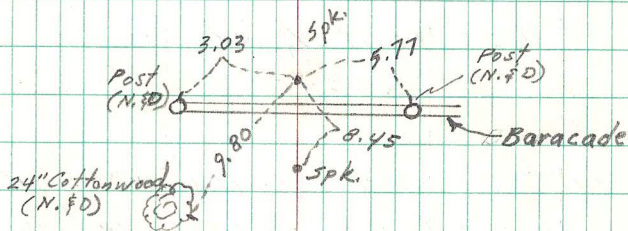

E IDAHO

AVE.

AVE.

Arc light ♂ 29.17

E HOYT AVE.
NOT $\frac{1}{4}$ line

Found rusty spike next
to MH

Hyd ♂ 38.89

WESTERN

BLVD.

ARLINGTON

AVE.

WHEELLOCK

Center
(C.I.)

