

Nov. - Dec. 1981

R.M.  
M.F.  
P.D.  
J.B.

45

P.K. OPEN SPACE (WILLOW LAKE)

single See Sec. 33-30-22

V= 94-58-56

S= 137.39

D= 136.870

for more info  
on section traverse

Center Sec. 33-30-22

(C.I.)

91-16-24

80-00-02

I.F.

single

V= 91-32-48

S= 942.206

D= 941.863

single

V= 102-06-48

S= 135.62

D= 132.60

Iron

I.F.

167-22-17


single

V= 91-26-20

S= 938.024

D= 937.728

125-38-03

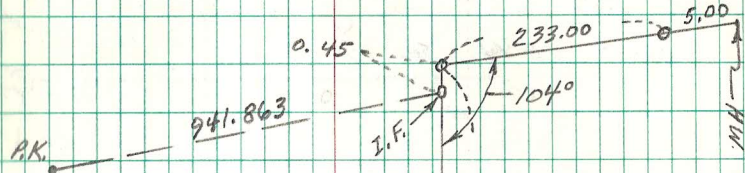

This survey is based upon  
moving 5/4 corner 6.69' east

