



OPEN SPACE (Co. Ditch NO. 18)

Part SE 1/4 Sec. 3-29-22

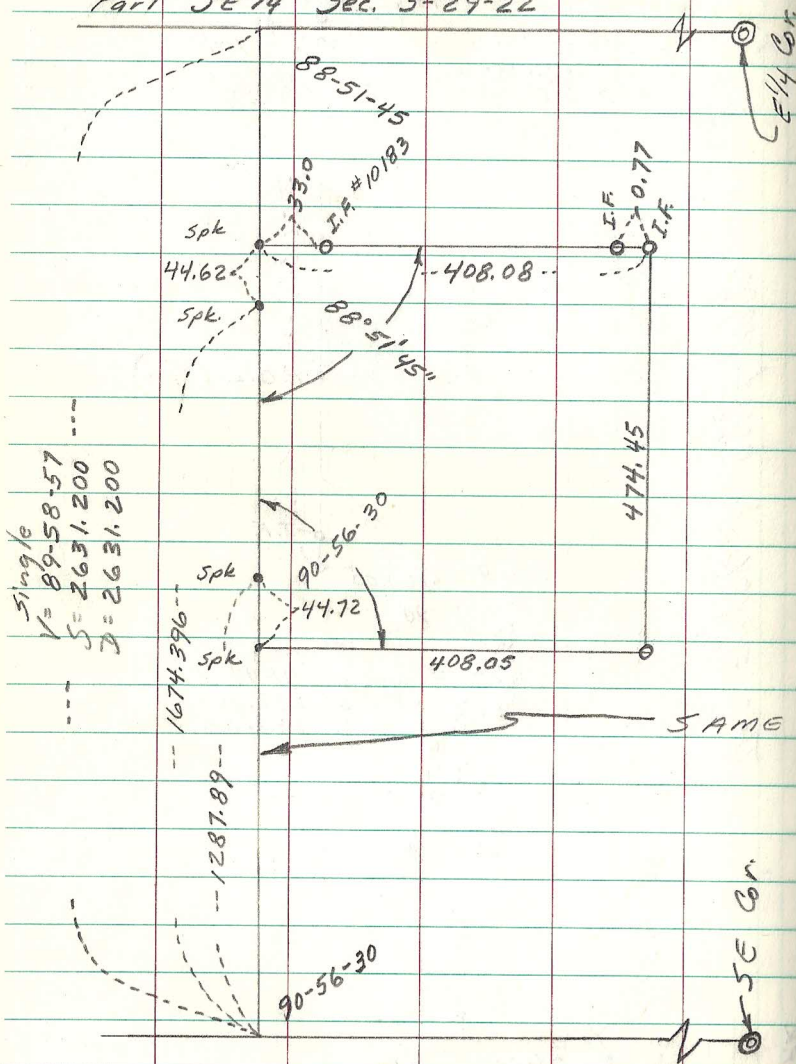

SAME

R.M. 1-6-83 26°
A.D.
D.S.

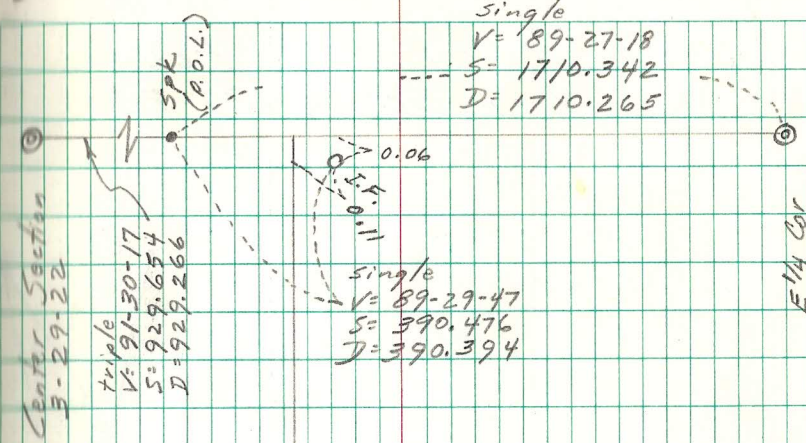

LINE

