SURVEY FOR:
PARISH OF THE HOLY SPIRIT

I hereby certify that pursuant to the Order of the District Court of Ramsey County, 2nd Judicial District, State of Minnesota, dated August 9, 2000, Court Order File No. C3-98-2906, Judicial Landmarks have been placed as shown on the annexed plat. Each Judicial Landmark consists of a cast iron monument 20 inches in length having a round top 4 inches in diameter with raised letters cast thereon reading, "Judicial Landmark" and having a round base 6 inches in diameter.

Dated this 15th day of August, 2000

SUNDE LAND SURVEYING, LLC

By John K. Barnes
John K. Barnes, R.L.S. Minn. Reg. No. 16456

Survey originally dated March 15, 2000.
REVISED: April 11, 2000. (Remove Gas Easement)
REVISED: August 15, 2000. (Recertify to Judicial Landmarks)

1610305

Registrar of Titles, Ramsey, MN
Date Filed: 8/25/00 4:00 PM
As Doc #: 1610305
On CT # (s):
517706,

Description of Parcel to be Registered
(Per Warranty Deed Document No. 3272319)

That part of the Northeast Quarter of the Southwest Quarter of Section 10, Township 28, Range 23, Ramsey County, Minnesota, lying South of the North 200 feet thereof; West of Cretin First Addition; North of the extension Westerly of the South line of Block 1, Cretin First Addition; and East of a line 100 feet Westerly of, and parallel to, the Westerly line of Block 1, Cretin First Addition.

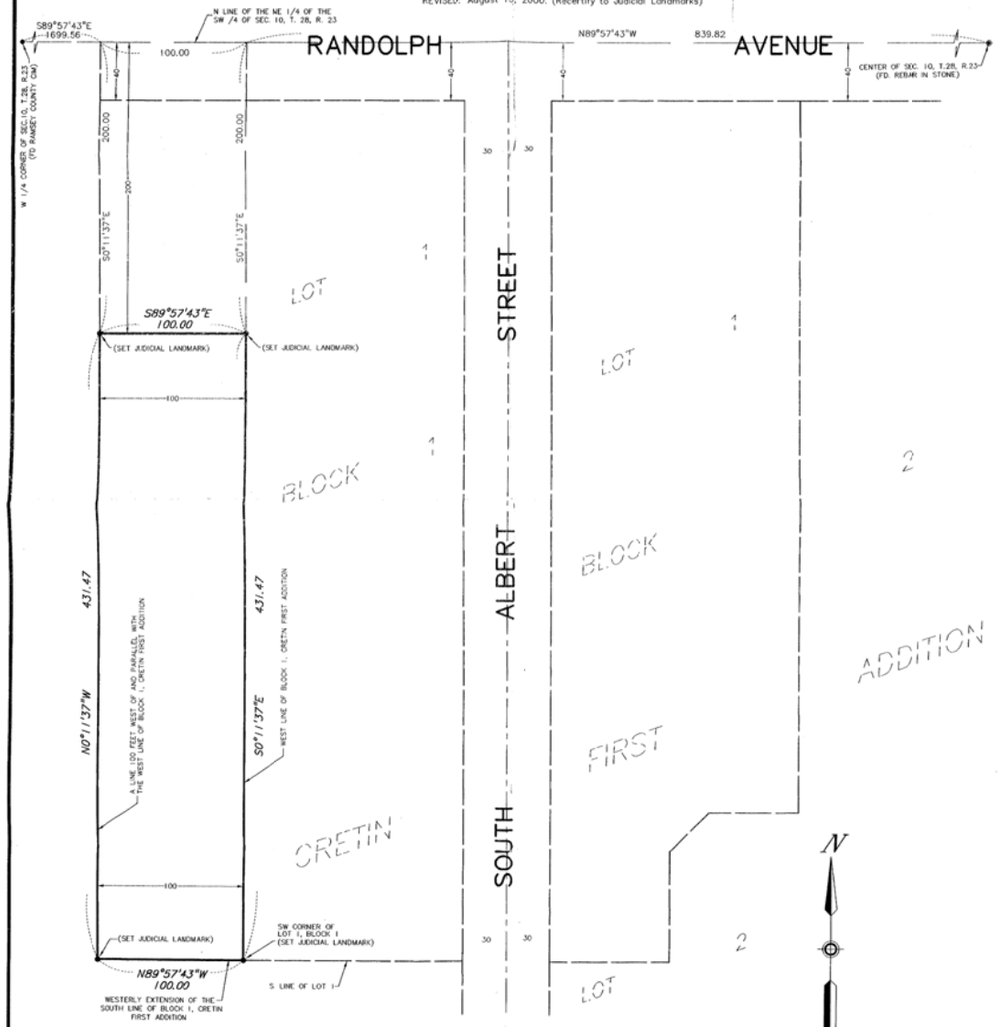

1.) This survey is a boundary survey only and does not purport to show physical features which exist on or near the subject property.

2.) Area of parcel to be registered: 43,147 Sq. Ft. or 0.991 Acres

Sunde Land Surveying, LLC.
9001 East Bloomington Freeway (35W) • Suite 118
Bloomington, Minnesota 55420-3435
Business: 612/881-2455 • FAX: 612/888-9526

96-050-HS1 495/13 (REF. 416/16) T.28, R.23, S.10 KTE/TLS 96050HS5.DWG