

174180

0173150

CERTIFICATE OF SURVEY

SURVEY OF


LOT 2, — DAYTON PLACE

SCALE 1 IN. = 20 FT.

Subscribed and sworn to
before me this 27 day of
September A.D. 1938
H. B. Lewis
NOTARY PUBLIC, RAMSEY CO. MINN.
MY COMMISSION EXPIRES
Aug 15, 1939

ST. PAUL, MINN. SEPT. 1938
I certify to having surveyed
the above described property
and that all distances and
locations as herein shown
are correct

Jens Pedersen
SURVEYOR
210 GLOBE BLDG.

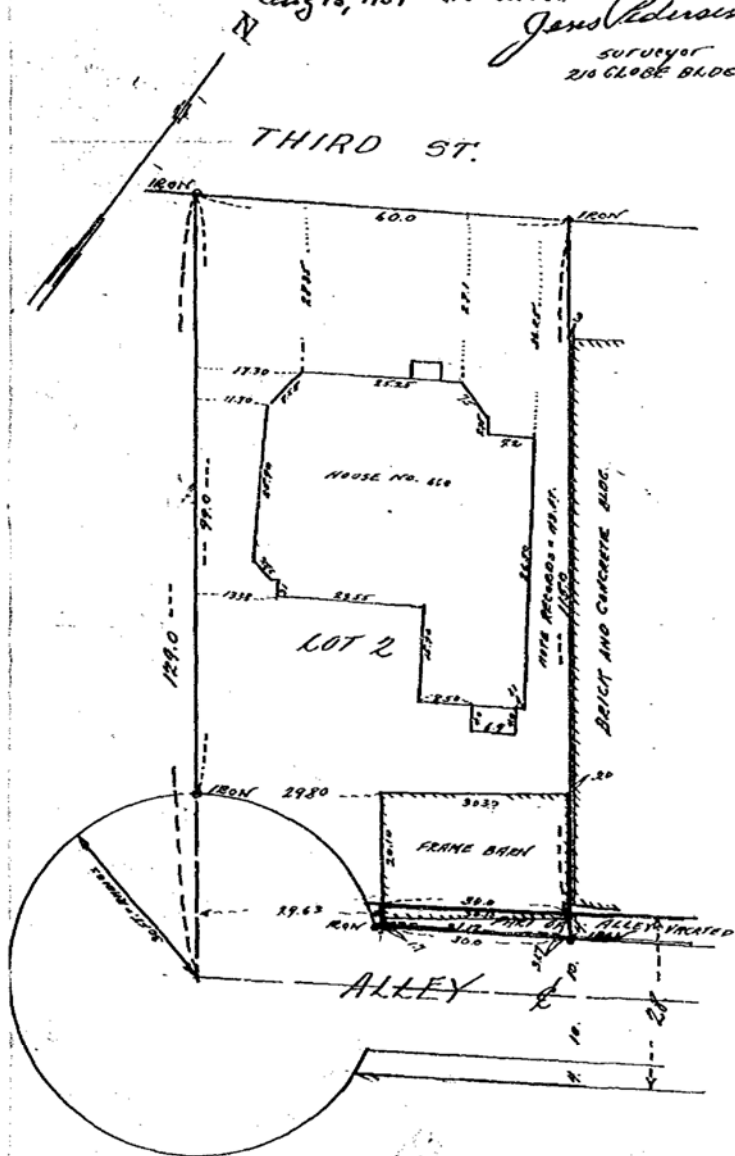

W-C-W-N-C-O

0174180

80/

11180

Certificate of Survey

Lot 2 - Dayton Place

3-2-11-180

CERTIFICATE NUMBER *12875*
 BOOK *204* PAGE *287*
 STATE OF MINNESOTA }
 COUNTY OF RAMSEY. } SS
 OFFICE OF THE REGISTRAR OF TITLES
 I HEREBY CERTIFY THAT THE ABOVE DESCRIBED
 INTEREST IS THE SAME AS SHOWN ON THE
 RECORDS OF THIS OFFICE AS OF THE DATE
30 DAY OF *NOV* A. D. *1938*
1/30 J. J. Gillen
 J. J. Choudhury

X