

44


FILED
Court Administrator

AUG 30 2006

By JAR Deputy
C2-98-2508

Certificate of Survey " JEFF HOWE"

Ramsey County Monument
Stone Monument
Witness Corner on West line
Section 11, T30, R22

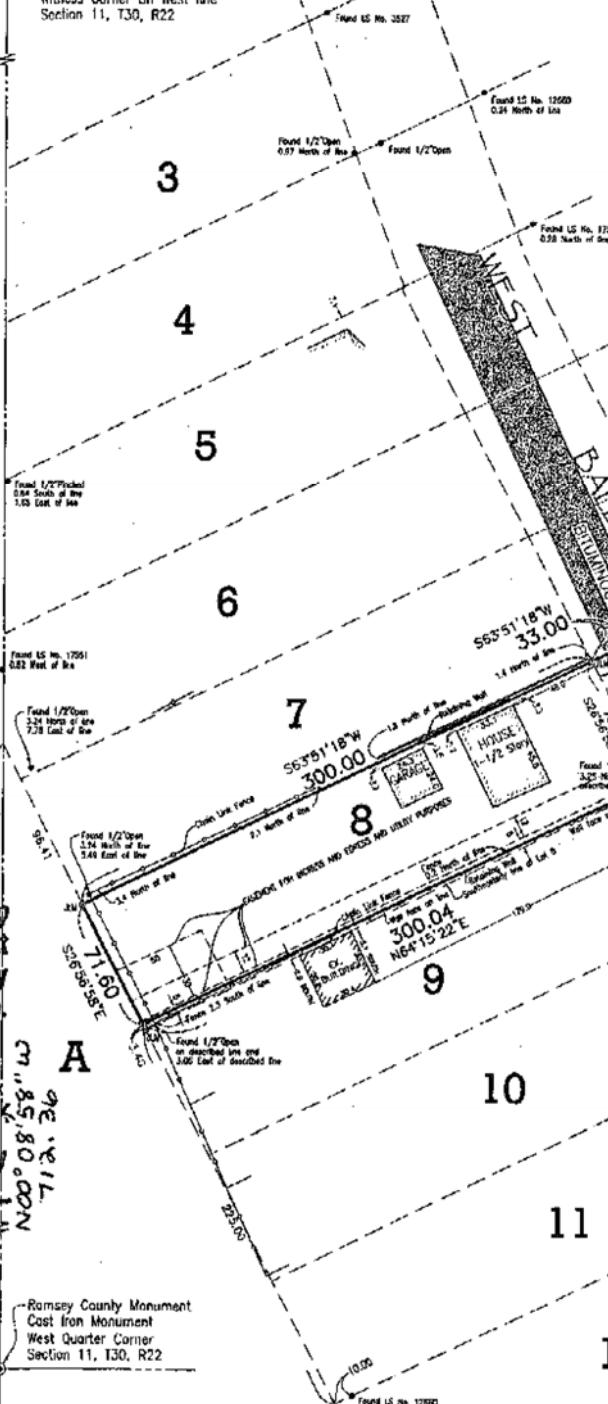

Document# 1976355
Certified Filed On 08/28/2006 0800
Registrar of Titles, Ramsey County, MN
Certificate# 560948 561983
5.2.3 160730

DESCRIPTION: PARCEL REGISTERED BY HOWE

Port of Lot 8, THE ERIE, Ramsey County, Minnesota, and all that real property including the excrements or reflections thereof lying southwesterly of Bald Eagle Lake and northwesterly of the southwesterly line of Bald Eagle Boulevard, (originally dedicated as County Road in said plot), described as follows:

Commencing at a judicial Landmark at the most northerly corner of said Lot 8; thence southwesterly along the northwesterly line of said Lot 8, 300 feet more or less to a judicial Landmark at the most westerly corner of said Lot 8; thence southeasterly along the southwesterly line of said Lot 8, to a judicial Landmark 3.40 feet northwesterly of a judicial Landmark at the most southerly corner of said Lot 8; thence northeasterly on a line to a judicial Landmark on the northeasterly line of said Lot 8, 130 feet northwesterly of a judicial Landmark at the most easterly corner of said Lot 8; thence northeasterly to a judicial Landmark at the most easterly corner of said Lot 8; thence northwesterly on the northeasterly extension of the southwesterly line of said Lot 8, 80 feet to a judicial Landmark at the intersection of said line and the northeasterly line of West Bald Eagle Boulevard, (originally dedicated as County Road in the plot of THE ERIE); thence continuing on the extension of said line 4.00 feet to a judicial Landmark; thence continuing on the extension of said line to the shore of Bald Eagle Lake; thence northeasterly along the shore of said lake to the intersection of a line drawn parallel with and 20 feet southwesterly of the northwesterly line and its extension of said Lot 8; thence southwesterly along said parallel line to a judicial Landmark; thence continuing on said parallel line 173.75 feet to a judicial Landmark; thence continuing on said parallel line and the northeasterly line of West Bald Eagle Boulevard, (originally dedicated as County Road in the plot of THE ERIE); thence continuing on said parallel line to the centerline of West Bald Eagle Boulevard; thence northwesterly along said centerline to the intersection with the northeasterly extension of the northwesterly line of said Lot 8; thence southwesterly along said extended line to the point of beginning.



LEGEND

- Denotes Iron Pipe Monument found
- Denotes Iron Pipe Monument set
- Denotes 4" by 20" Cast Iron Judicial Landmark set
- △ Denotes Chain Link Fence
- Denotes Wood Fence

YNAE K.E. OLSON, Court Administrator, Ramsey County, State of Minnesota, does hereby certify that the attached instrument is a true and correct copy of the original on file and of record in my office.

Dated this 30th day of August, 2006.

YNAE K.E. OLSON, Court Administrator
By Ronald P. Albin, Deputy
File No. C2-98-2508

N00°08'58"E

N00°08'58"S

N00°08'58"E</