

14


Document# 2069798
Certified Filed On 04/17/2009 1000
Registrar of Titles, Ramsey County, MN
Certificate# 575150
4.3.2 436073

OK to file
per NAB

14

1197 UNIVERSITY AVENUE WEST
CITY OF ST. PAUL, RAMSEY COUNTY, MINNESOTA

FILED
Court Administrator
APR 15 2009
By Lie Deputy

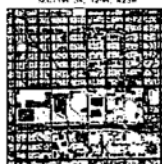




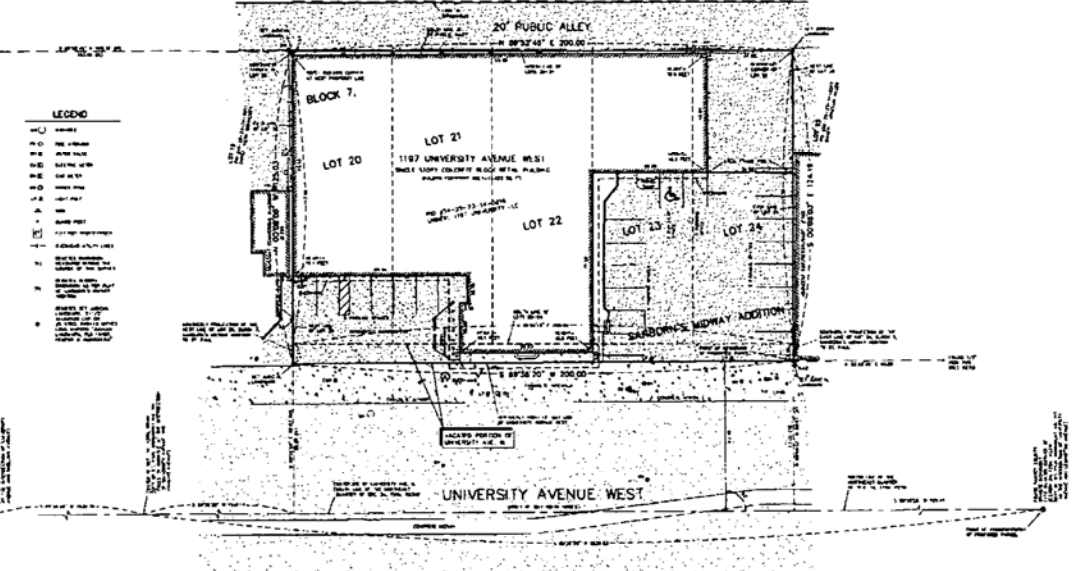

LEGEND











1-2

LYNAE K.E. OLSON, Court Administrator, Ramsey County, State of Minnesota, does hereby certify that the attached instrument is a true and correct copy of the original on file and of record in my office.



Dated this 16th day of April, 2008
BY Lynae K.E. Olson Court Administrator
Deputy
File No. 162-CV-07-2259