



Ramsey County

Property Records and Revenue

Abstract, Title and Ownership

Committed to exceptional service

①

Document# 2186550
Certified Filed On 09/27/2012 1300
Registrar of Titles, Ramsey County, MN
Certificate# 575238
4.2.4 739379

Certificate of Survey

Certificate No. 575238

35.29.22.21.0003

Page added by Ramsey County
To provide recording certification
Do not remove


CERTIFICATE OF SURVEY

LAKE AND LAND SURVEYING, INC.
1296 Hudson Road, St. Paul, Minnesota 55106
Phone: 651-776-6211

Survey Made For:
Mr. Mark Nuernberg
697 Ruth Street, St. Paul, MN

FILED
Court Administrator
SEP 21 2012
By MAC Deputy

Legal Description:
The South 110 feet of Lots 1 & 2, Block 1, ROBERT L. WARE'S
EASTERN HEIGHTS, Ramsey County, Minnesota.

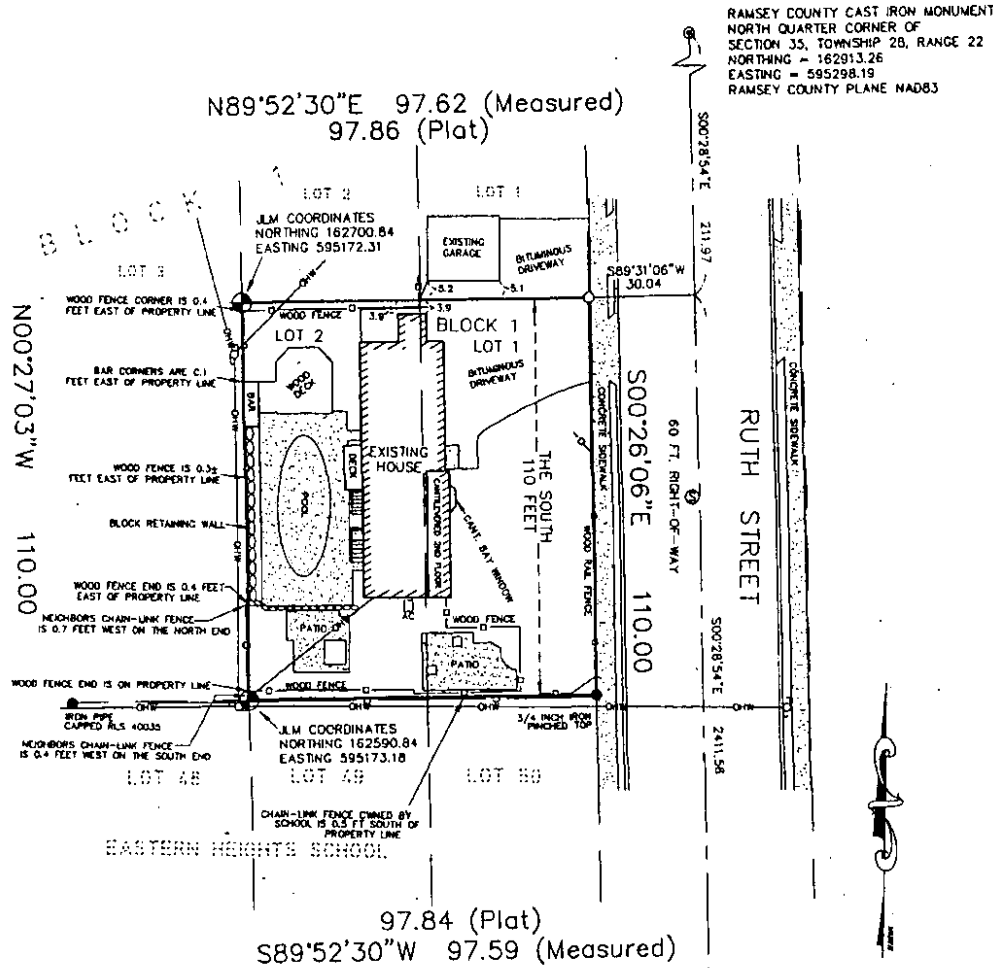

- ⊙ Denotes Ramsey County Cast Iron Monument
 - ⊕ Denotes Judicial Land Monument set.
 - Denotes PK Nail set with Stainless Steel Washer Stamped RLS 16464.
 - Denotes Iron Monument found size, type, & R.L.S. No. as noted.
 - OH— Denotes Overhead Utility Wires
 - ▭ Denotes Concrete Surface
- SITE ADDRESS: 697 Ruth Street, St. Paul, MN
- BASIS OF BEARINGS: ASSUMED
LAKE & LAND SURVEYING, JOB NO. 2011.132

I certify that this survey, plan or report was prepared by me or under my direct supervision, and that I am a duly Registered Land Surveyor under the laws of the State of Minnesota.

Jonathan L. Faraci September 11, 2012
Jonathan L. Faraci
Registered Land Surveyor & Registered Engineer
Minnesota Registration No. 16464

SCALE
1 inch = 30 ft.

LYNAE K.E. OLSON, Court Administrator, Ramsey County, State of Minnesota, does hereby certify that the attached instrument is a true and correct copy of the original on file and of record in my office.

Dated this 21st day of September, 2012
LYNAE K.E. OLSON, Court Administrator
By Lynae Olson Deputy
File No. 68-CV-11-9270

