

Certified, filed and/or recorded on Mar 17, 2017 8:06 AM


Pkg ID 1180253C Office of the Registrar of Titles Ramsey County, Minnesota Susan R Roth, Registrar of Titles Christopher A. Samuel, County Auditor and Treasurer

Deputy 405

\$46.00 Document Recording Fee Torrens

\$46.00 Document Total

Existing Certs 612371

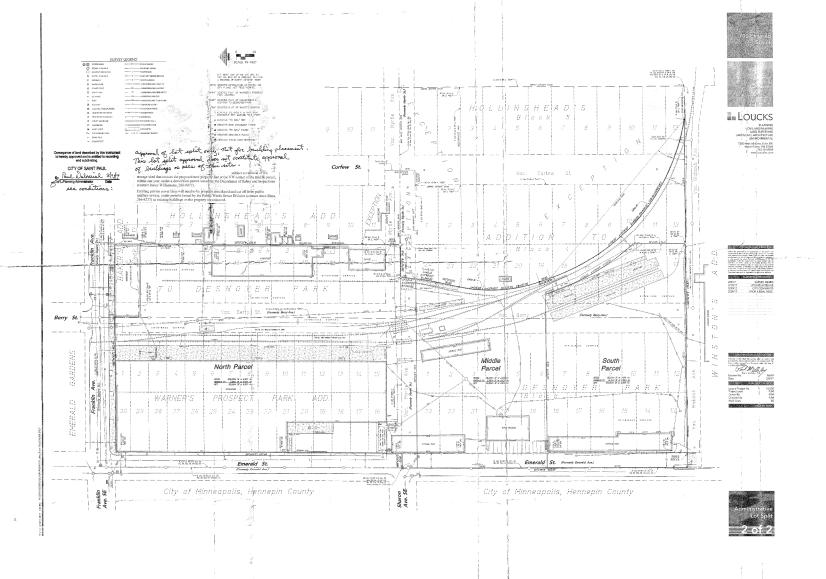

EXISTING DESCRIPTION (P.I.D. No. 292923330021)

Lot 2, Block 12, Baker's Addition.

AND

Warner's Prospect Park Addition to St. Paul.

That part of scaned Berny Jacons, deficially in the placed Black's Addition, In him placemen the southerly fire of Frankis States, dedicated as byput States in the placed of Black's Addition, and the second relatively less of Lake's Addition, and the second relatively less of Lake's Addition, and the special counted Barry Adminish, and decicated in the place of Waters's Propact Park Addition, 

And that part of vacated Myrtle Street, descated in the plat of Warner's Prospect Park Addition, lying between the East line of Berry Avenue dedicated in the plat of Warner's Prospect Park Addition; and the southerly extension of the west line of Lot 16, Warner's Prospect Park Addition.

A piece of land described as follows: Configuration, as the Northwest control of Section 30, Tourning 26, Rouge 21 serving stress South 223, 6 let thereo. Earth 6425 feet brown better 0,023 feet in the probe vites 494.5 feet for the pileon of largering, containing 1250 gases, more or base lavels in the Northwest Outster of Section 32, Tourning 29, Range 23, subject to an essement for a public street on a strip of land 30 feet wide off the Worth side of sada premises, and all the seather on a strip of land 30 feet wide off the Worth side of sada premise.

"District for promises, and a like assertiment on a trip of famed 30 feet vision of the West side of said premises.



ALSO EXCEPT the following: Lot 11, Block 2 grad Hollinshead's Addition to Desnoyer Park

AND ASC DECEPT. that certain hear or yell, of fined described an followin, to well: Commencing at the Southwest corner of said Lot 11; thence South 33 forest stong like enterted West like of said, 6.11 is the incensition on the Offseth or allowing on said platt, thrence West along the contact like of Myriak Avenue vacated 7.

Ramsey County, Minnesota Torrens Property Torrens Certificate No. 612371

Lots Tendrus (12), Thirteen (13), Fourtuen (19): Fifteen (15), Soxteen (16), Seventeen (17), Eighteen (18), Nineteen (19), Twenty Twonty-two (22), in Block Two (2) in Hollinshed's Addition to Desnoyer Park, Ramsey County, Mininesota, according to the recorded plat thereof AND

A step of land between the South line of Bignet Street and the North line of Myntle Aurunu, as vacated, being part of so called Barry Avenue, as vacated, bying between Warner's Prospect Park Addids to St. Paul, and Block Two CJI, Hollisahead's Addition to Dewoyer Park, Barring County, Minnescola.

ALSO be North Hall of a sair of all not between the East los of illended Avenue and the come line of Culric Avenue, being part of social Myntle Avenue, as vacated, Jring South of Warner's Prospect Park Addition to St. Paul, and Block Two (2) Hollisahead's Addition to Develoyer Park, Barring County, Minnescola, all according to the recorded pullshawed.

EXCEPTING therefrom that part of Myrtle Avenue, as vacated lying Easterly of the following described line to-wit:

Commencing at the Suchiment comm of late 11, Block 2, Bildhousely Audition to Demoyor Park, Bossey County, Minnesons, thorac South 33 feet along the extended West line of said length to the center line of Myrth America, securics, as about on said play there. West along the center line of Myrth America, securics, as about on said play there. West along the center line of any Myrth America, securics, 248 feet to a South 19 Feet East of the center line of the super tool mannious line of Block 4, Hollinshould's Addition to Descripe Park.

PROPOSED DESCRIPTION NORTH PARCEL - LOT SPLIT

Lot 2, Block 12, Baker's Addition, Ramsey County, Minnesota,

Lots 1 through 30, inclusive, Warner's Prospect Park Addition to St. Paul, Ramsey County, Minnesota.

That part of vacated Berry Stroct (formerly Berry Avenue as dedicated in the plot of Baker's Addition to the City of St. Paul, Ramwey County, Minnesota), lying belween the southerly lim of Pranklin Street, dedicated as Bayard Street in the plot of said Baker's Addition to the City of St. Paul, and the westerly extension of the southerly lim of 10 Lot 2 (Bock 12, acid Baker Addition to the City of St. Paul.)

Lots 12 through 22, inclusive, Block 2, Hollinshead's Addition to Desnover Park, Ramsey County, Minnesota.

AND

The cast half of Berry Street vacated (formerly Berry Avenue) lying between the westerly extension of the southerly line of Lot 2, Block 12, said Baker's Addition to the City of St. and the North line of Myrtle Avenue, as vacated.

That part of vacated Berry Avenue, dedicated in the plat of said Warner's Prospect Park Addition, lying south of the southorly "like" of Friehllin "Avenue" (formerly Franklin Strivet, and dedicated as Bayard Street in the plat of said Warner's Prospect Park Addition) and north of the easterly extension of the south like of Lot 15 said Warner's Prospect Perk Addition.

AND

The North half of Myrtle Avenue, wacsted lying east of the center line of vacated Berry Street and lying west of the southerly extension of the west line of Lot 13. Block 2, Hollinshead's Addition to Desnoyer Park, Ramsoy County, Minnesota.

that part of the North half of vacated Myrile Street lying west of the center line of vacated Berry Street and east of the southerly extension of the west line of pt 16, said Warner's Prospect Park Addition.



MIDDLE PARCEL - LOT SPLIT

Those parts of Lots 1 through 6, inclusive, Block 3, Hollinshead's Addition to Doznoyer Park, Rameny County, Minnesota; Lots 18 through 22 load Block 3, Emmed Sinter bling west of saled Block 3; Lots 9 through 12; inclusive and Lots 15 through 24, inclusive, Block 4, said Hollinshead's Addition to Deepsoyer Park, Lots 15; Brock 2, and Hollinshead's Addition to Deepsoyer Park, vesteded Curler's Secret bling between sale Block 3 and 5; 




SOUTH PARCEL - LOT SPLIT

Those parts of Lots 6 through 18, inclusive, Block 3, Hollinhand's Addition to Demoyer Park, Ramsay County, Minnesota: Lots 13 throughly; Block 4, said Hollinhand 3: Addition to Demoyer Park, Emeried Steere Infog west of add 80ck 3; 











217	SURVEY ISSU
3/17	UPDATE ACREA
3/17	CITY COMME
4/17	PROP. LEGAL DE



