

Doc No **T02666413** 

Certified, filed and/or recorded on May 29, 2020 10:39 AM

Office of the Registrar of Titles
Ramsey County, Minnesota
Tara J Bach, Registrar of Titles
Christopher A. Samuel, County Auditor and Treasurer


Deputy 501 Pkg ID 1362232M

Document Recording Fee Torrens \$46.00

Document Total \$46.00

**Existing Certs** 

633090

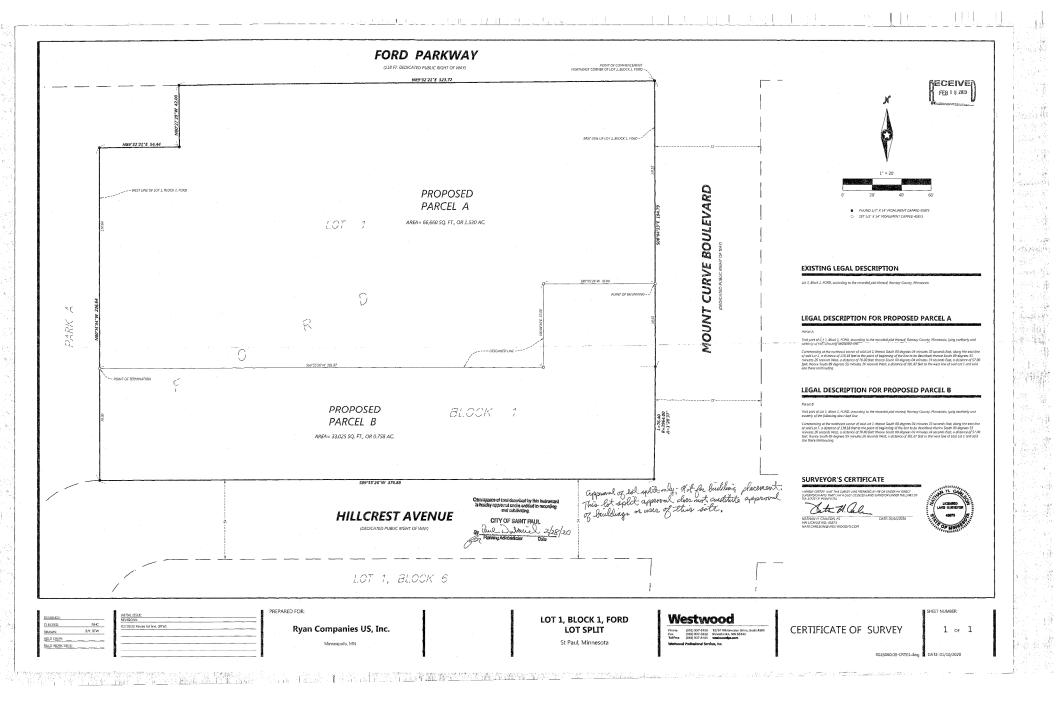





## CITY OF SAINT PAUL

Melvin Carter, Mayor

25 West Fourth Street Saint Paul, MN 55102 Telephone: 651-266-6700 Facsimile: 651-228-3220

February 28, 2020

Tony Barranco Ryan Companies 533 South Third Street, Suite 100 Minneapolis, Minnesota 55415

RE: 2192 Ford Parkway Lot Split - Final Approval

Zoning File #20-012-766

Dear Mr. Barranco:

The proposed subdivision of Lot 1, Block 1 of the FORD plat at 2192 Ford Parkway (PIN 17-28-23-12-0081) is hereby approved for compliance with the City of Saint Paul's subdivision regulations.

The enclosed stamped and signed survey as approved by the Planning Administrator is your record of lot split approval by the City of Saint Paul, which is required in order to record a lot split. It is the responsibility of the property owner to record the lot split with Ramsey County.

This approval by the Planning Administrator will expire two years from the date of this letter if you have not yet recorded the proposed lot split, unless the Planning Administrator (at your request) has granted an extension not to exceed one year as provided in Legislative Code § 61.105. Any interested party may appeal this decision by the Planning Administrator to the Planning Commission within ten days as provided in § 61.701.

Call me at 651-266-6583 if you have any questions.

Sincerely,

Paul Dubruiel, on behalf of the Planning Administrator

cc: Highland District Council

Anthony Adams, Ryan Companies

Menaka Mohan, Dept. of Planning & Economic Devt.

Ashley Skarda, Dept. of Safety and Inspections

Jim Brown, Dept. of Public Works

Nathan Carlson, Westwood Professional Services, Inc.

When Recorded Return To:

First American Title Insurance Company
National Commercial Services
121 South 8th Street, Suite 1259
Minneapolis, MN 55402
File No: NCS 204494-8