CERTIFICATE OF SURVEY FOR: Deborah Allen, #165 Owasso Ln E., Shoreview, MN

RECEIVED
AUG 16 2004
BY:

LEGAL DESCRIPTION

Present Description:
The West 200 feet of the East 333 feet of the North 120 feet of the South 439 feet of Gov't. Lot 5, Section 36, Twp. 30, Range 23, Ramsey County, Minnesota.

Proposed Descriptions:

The West 91.20 feet of the East 224.20 feet of the North 120.00 feet of the South 439.00 feet, of Gov't. Lot 5, Section 36, Twp. 30, Range 23, Ramsey County, Minnesota.

The West 108.80 feet of the East 333.00 feet of the North 120.00 feet of the South 439.00 feet of Gov't. Lot 5, Section 36, Twp. 30, Range 23, Ramsey County, Minnesota.

LEGEND

○ Denotes Set Pipe/Rebar R.L.S. No. 19162
● Denotes Found Iron Pipe
△ Denotes Set P.K. Nail

DESCRIPTION
See above

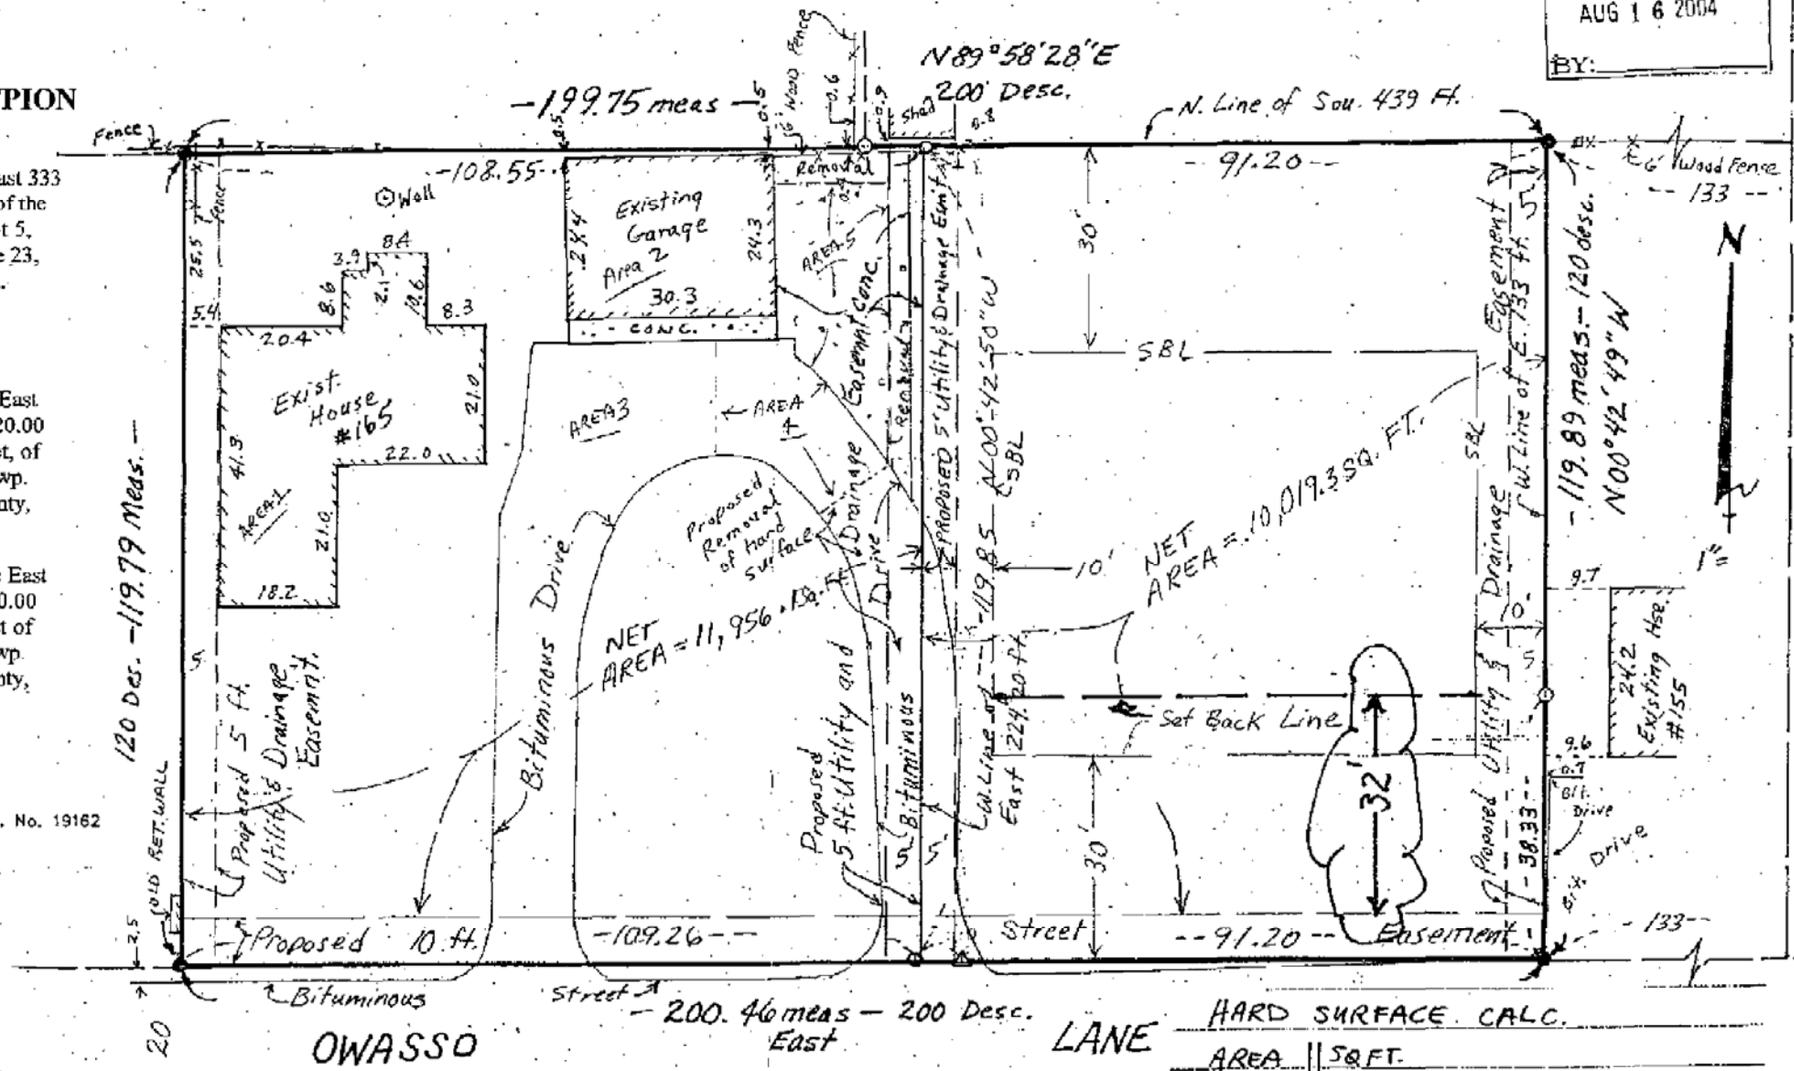

HARD SURFACE CALC.

AREA	SQ FT.		
1	1236.4		
2	793.9	4335.6	
3	1306.1	11956.1	= 36.3%
4	405.0		
5	594.2		
TOTAL	4335.6		

CERTIFICATION

I hereby certify that this survey, plan or report was prepared by me or under my direct supervision and that I am a duly Registered Land Surveyor under the laws of the State of Minnesota.

Barton G. Ahrens Dated: 6/26/04
Revised 8/16/04

Barton G. Ahrens
MN Reg. No. 19162

Note:
Easements may exist.
No title opinion was used for this survey

Document# 3937845
Recorded 03/22/2006 1500
County Recorder, Ramsey County, MN
43.2. 115139