



Doc No **A04847360**

Certified, filed and/or recorded on
Nov 24, 2020 9:33 AM

Office of the County Recorder
Ramsey County, Minnesota
Todd J. Uecker, County Recorder
Christopher A. Samuel, County Auditor and Treasurer

Deputy 303

Pkg ID 1404007M

Document Recording Fee Abstract	\$46.00
<i>Document Total</i>	\$46.00

LEGAL DESCRIPTION:


Lot 11, Block A, Marshall Boulevard Addition to the City of St. Paul, Ramsey County, Minnesota.

SCOPE OF WORK & LIMITATIONS:

1. Showing the length and direction of boundary lines of the legal description listed above. The scope of our services does not include determining what you own, which is a legal matter. Please check the legal description with your records or consult with competent legal counsel, if necessary, to make sure that it is correct and that any matters of record, such as easements, that you wish to be included on the survey have been shown.
2. Showing the location of observed existing improvements we deem necessary for the survey.
3. Setting survey markers or verifying existing survey markers to establish the corners of the property.
4. Existing building dimensions and setbacks measured to outside of siding or stucco.
5. This survey has been completed without the benefit of a current title commitment. There may be existing easements or other encumbrances that would be revealed by a current title commitment. Therefore, this survey does not purport to show any easements or encumbrances other than the ones shown hereon.

STANDARD SYMBOLS & CONVENTIONS:

"●" Denotes iron survey marker, set, unless otherwise noted.

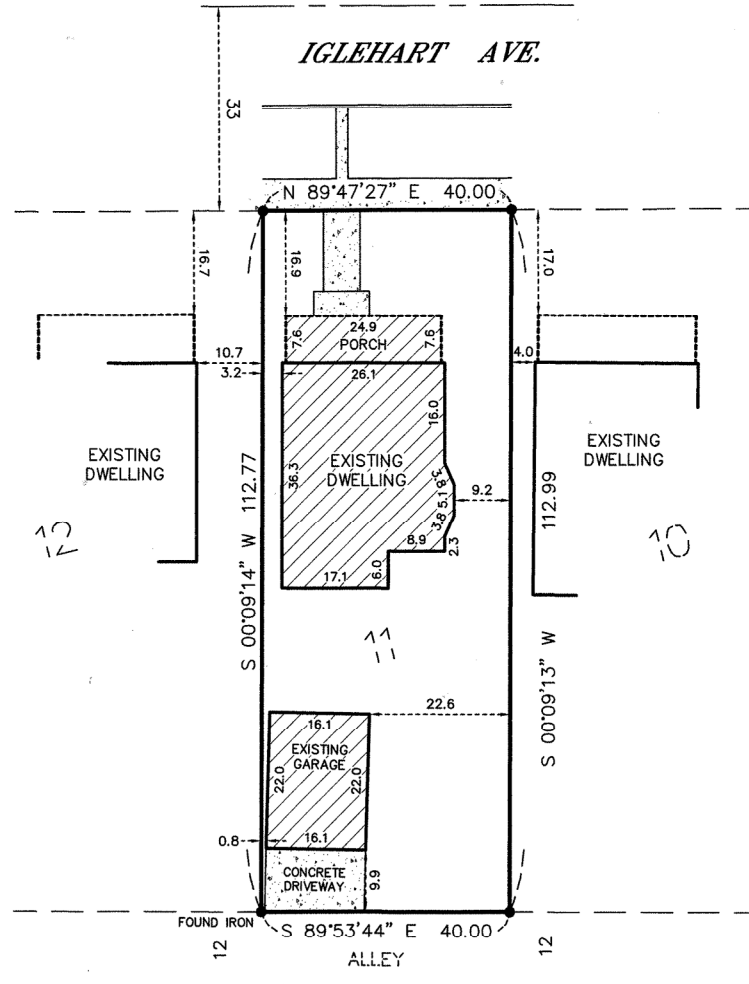

DATE	REVISION DESCRIPTION	DRAWING ORIENTATION & SCALE	CLIENT/JOB ADDRESS	Advance Surveying & Engineering, Co.	I HEREBY CERTIFY THAT THIS PLAN, SURVEY OR REPORT WAS PREPARED BY ME OR UNDER MY DIRECT SUPERVISION AND THAT I AM A DULY REGISTERED LAND SURVEYOR UNDER THE LAWS OF THE STATE OF MINNESOTA.	DATE SURVEYED:	SHEET TITLE	SHEET NO.
			ANURA SI-ASAR 964 IGLEHART AVE. ST. PAUL, MN	17917 Highway No. 7 Minnetonka, Minnesota 55345 Phone (952) 474-7964 Web: www.advseur.com	Wayne W. Preutz #43503 LICENSE NO.	JULY 24, 2020	EXISTING SURVEY	S1
						DATE DRAFTED: JULY 25, 2020	SHEET SIZE: 11 X 17 DRAWING NUMBER 200994 WP	