


Doc No A04941188

Certified, filed and/or recorded on Apr 4, 2022 3:29 PM

Office of the County Recorder
Ramsey County, Minnesota
Todd J. Uecker, County Recorder
Heather L. Bestler, County Auditor and Treasurer

Deputy 309 Pkg ID 1516533D

Document Recording Fee Abstract \$46.00 **Document Total** \$46.00

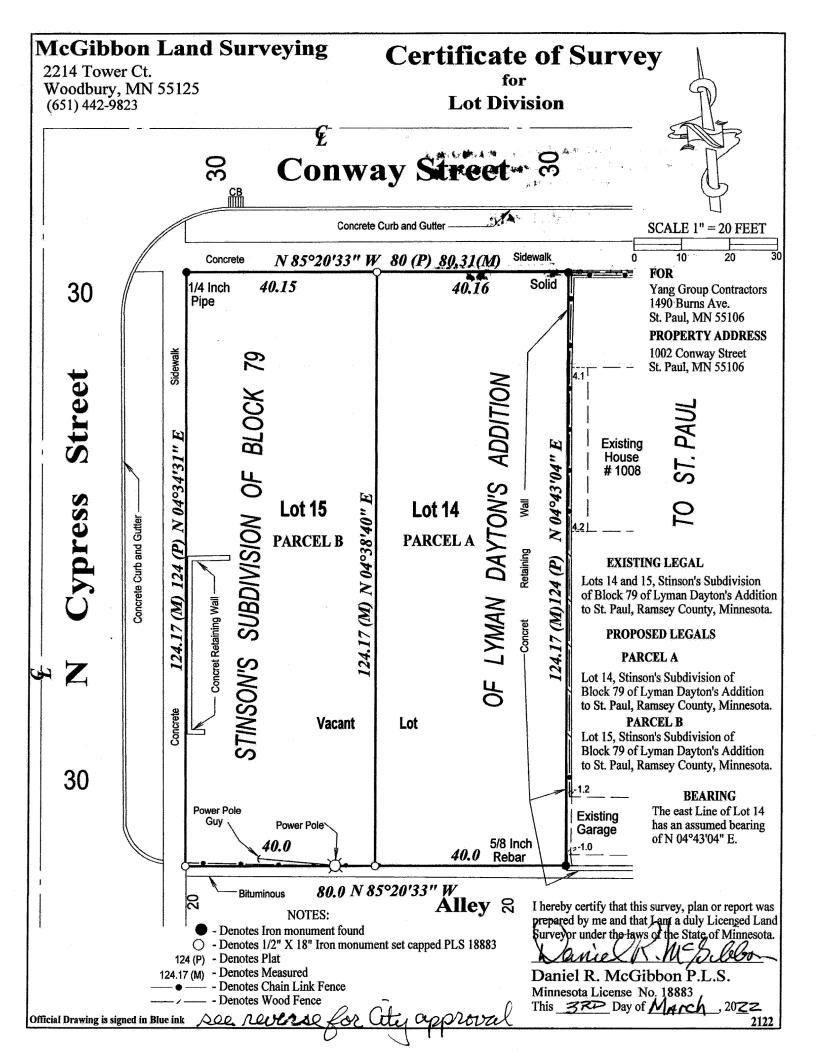

Conveyance of land described by this instrument is hereby approved and is entitled to recording and substituting.

CITY OF SAINT PAUL

Plenning Administrates

40