

0918685

J. E. GOCKOWSKI, District Court Administrator,
Ramsey County, State of Minnesota, does hereby
certify that the attached instrument is a true
and correct copy of the original on file and
of record in my office.
Dated this 29 day of March, 1990
J. E. GOCKOWSKI, District Court Administrator
By *[Signature]* Deputy
File No. T 12520




T 12520
FILED
MAR 15 1990
J. E. GOCKOWSKI
DISTRICT COURT ADMINISTRATOR

I hereby certify that this Certificate of Survey Description Easement Plan Specification
 or Building Location was prepared by me or under my direct supervision and that I am a duly
Registered Land Surveyor under the laws of the State of Minnesota.

David E. Torgersen Reg. No. 17551 Date 12-6-89

BIRCH LAKE

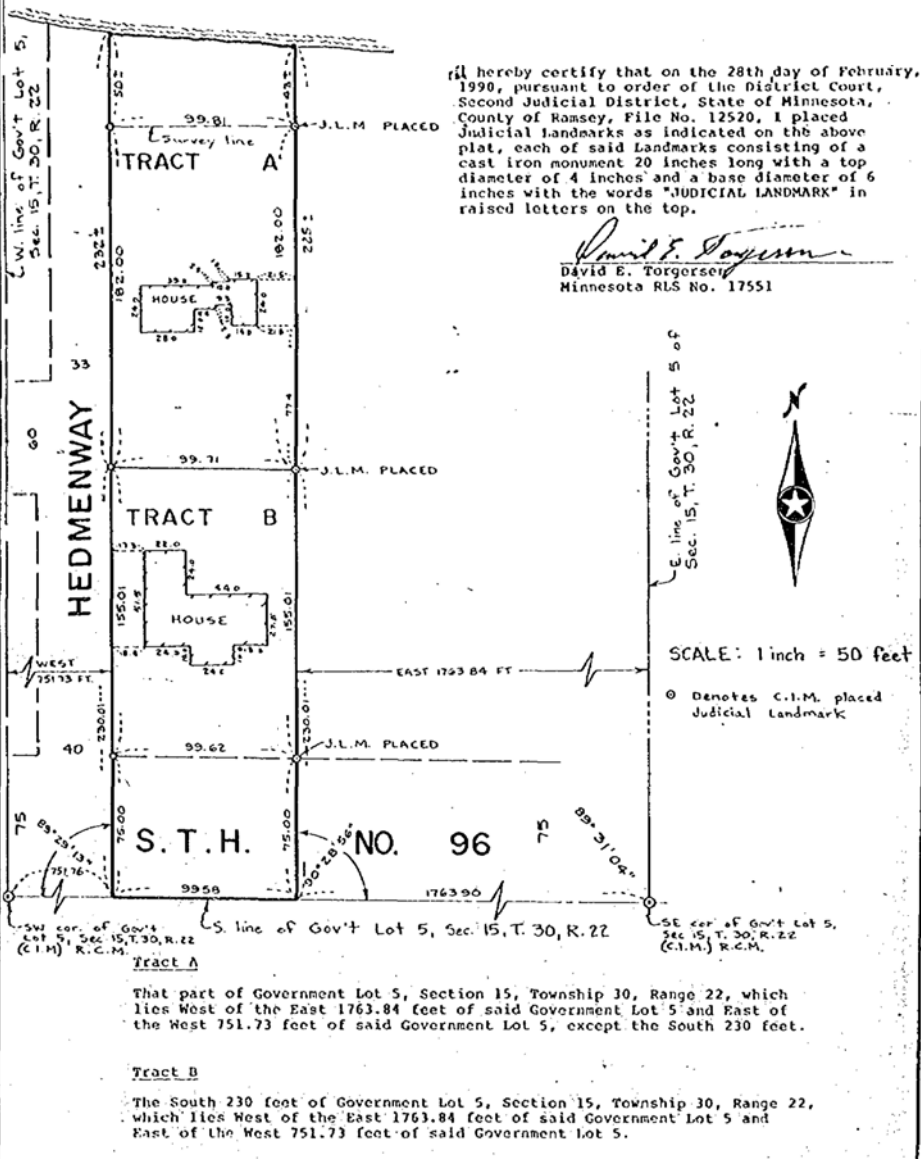

I hereby certify that on the 28th day of February, 1990, pursuant to order of the District Court, Second Judicial District, State of Minnesota, County of Ramsey, File No. 12520, I placed Judicial Landmarks as indicated on the above plat, each of said Landmarks consisting of a cast iron monument 20 inches long with a top diameter of 4 inches and a base diameter of 6 inches with the words "JUDICIAL LANDMARK" in raised letters on the top.

David E. Torgersen
David E. Torgersen
Minnesota RLS No. 17551



E. line of Gov't Lot 5 of Sec. 15, T. 30, R. 22

SCALE: 1 inch = 50 feet

o Denotes C.I.M. placed Judicial Landmark

0918685

Tract A
That part of Government Lot 5, Section 15, Township 30, Range 22, which lies West of the East 1763.84 feet of said Government Lot 5 and East of the West 751.73 feet of said Government Lot 5, except the South 230 feet.

Tract B
The South 230 feet of Government Lot 5, Section 15, Township 30, Range 22, which lies West of the East 1763.84 feet of said Government Lot 5 and East of the West 751.73 feet of said Government Lot 5.

89-211
853-16

0918685


004-3861

31 200974

740 - 484-346 984

CERTIFICATE NUMBER 346983
 BOOK 740 PAGE 473
 COUNTY OF MINNESOTA SS
 STATE OF MINNESOTA

BY J. O. Hansen
 DEPUTY

OF AND OF THE REGISTRAR OF TITLES
 THIS CERTIFICATE FOR THE WITHIN INSTRUMENT WAS
 ISSUED AT THE OFFICE OF ST. PAUL, MINN. ON THE
25th DAY OF April A.D. 1984
 FOR THE PURPOSE OF A

