0956378

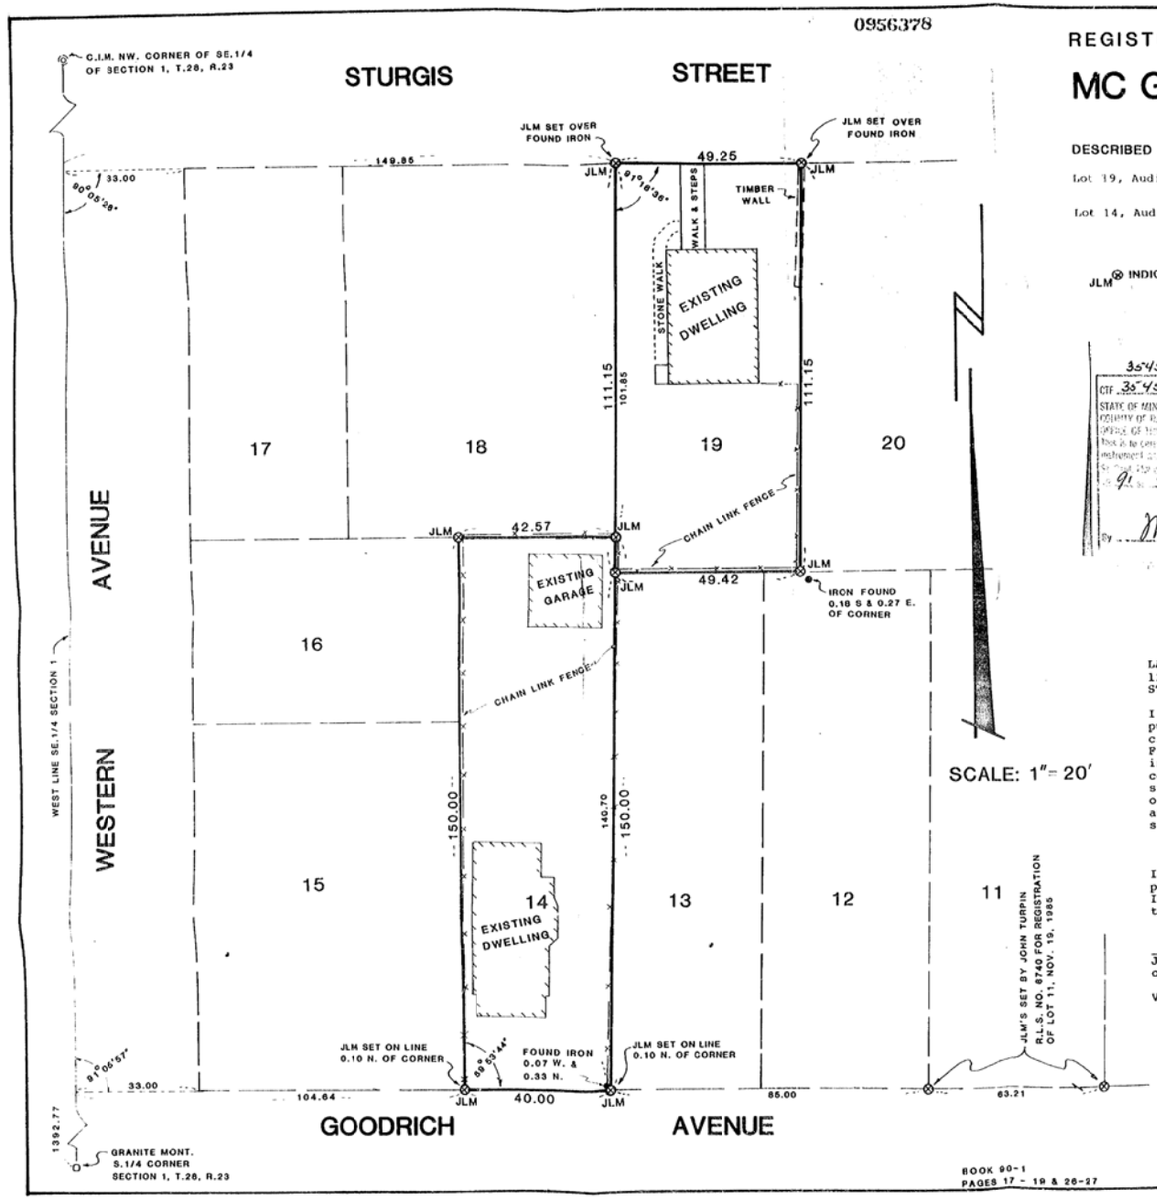

BOOK 90-1
PAGES 17 - 19 & 26-27

REGISTRATION SURVEY ORDERED BY:

MC GUIGAN & MC GUIGAN

DESCRIBED AS:

Lot 19, Auditor's Subdivision No. 65.
AND
Lot 14, Auditor's Subdivision No. 65.

C8 90 12460

FILED
AUG 16 1991
J.E. GOCKOWSKI
COURT ADMINISTRATOR
By _____ Deputy

JLM ⊗ INDICATES J.L.M. SET

J. E. GOCKOWSKI, Court Administrator
Ramsey County, State of Minnesota, does hereby certify that the attached instrument is a true and correct copy of the original on file and of record in my office.
Dated this 16 day of Aug, 19 91
J. E. GOCKOWSKI, Court Administrator
By _____ Deputy
File No. C8 90 12460

354522 756 82
CTF 354521 BK 756 PG 81
STATE OF MINNESOTA SS
COUNTY OF RAMSEY
OFFICE OF THE REGISTRAR OF TITLES
This is to certify that the within instrument was filed in this office at 9 o'clock A.M. this 21 day of Aug 91
JOHN SORENINA
Registrar of Titles
By M. Cusen
Deputy

LAKE & LAND SURVEYING, INC.
1296 HUDSON ROAD 776-6211
ST. PAUL, MN 55106

I hereby certify that on the 16th day of July, 1991, pursuant to order of the District Court, Second Judicial District, State of Minnesota, County of Ramsey, File No. C8-90-12460, I placed Judicial Landmarks as indicated on the adjoining plat, each of said Landmarks consisting of a 2 1/2" diameter aluminum cap being stamped "J.L.M. R.L.S. 14887" and affixed to the top of a 15" long section of 5/8" diameter reinforcing bar and being set flush with the ground. An X on the top of said cap marks the exact point.

AND

I hereby certify that this survey, plan or report was prepared by me or under my direct supervision and that I am a duly Registered Land Surveyor under the laws of the State of Minnesota.

James E. Danley
James E. Danley Minn. R.L.S. No. 14887
on the 22ND day of JULY 19 91.

VALID ONLY WHEN STAMPED WITH IMPRESSION SEAL.

Code II	1300
Title Co.	CL
Typist	
Tract Index	
Register	
Fee	30
Copy	

000-0018 01 3000AR