


SECTION 13 T. 28 R. 22 X

12

LINWOOD AVENUE

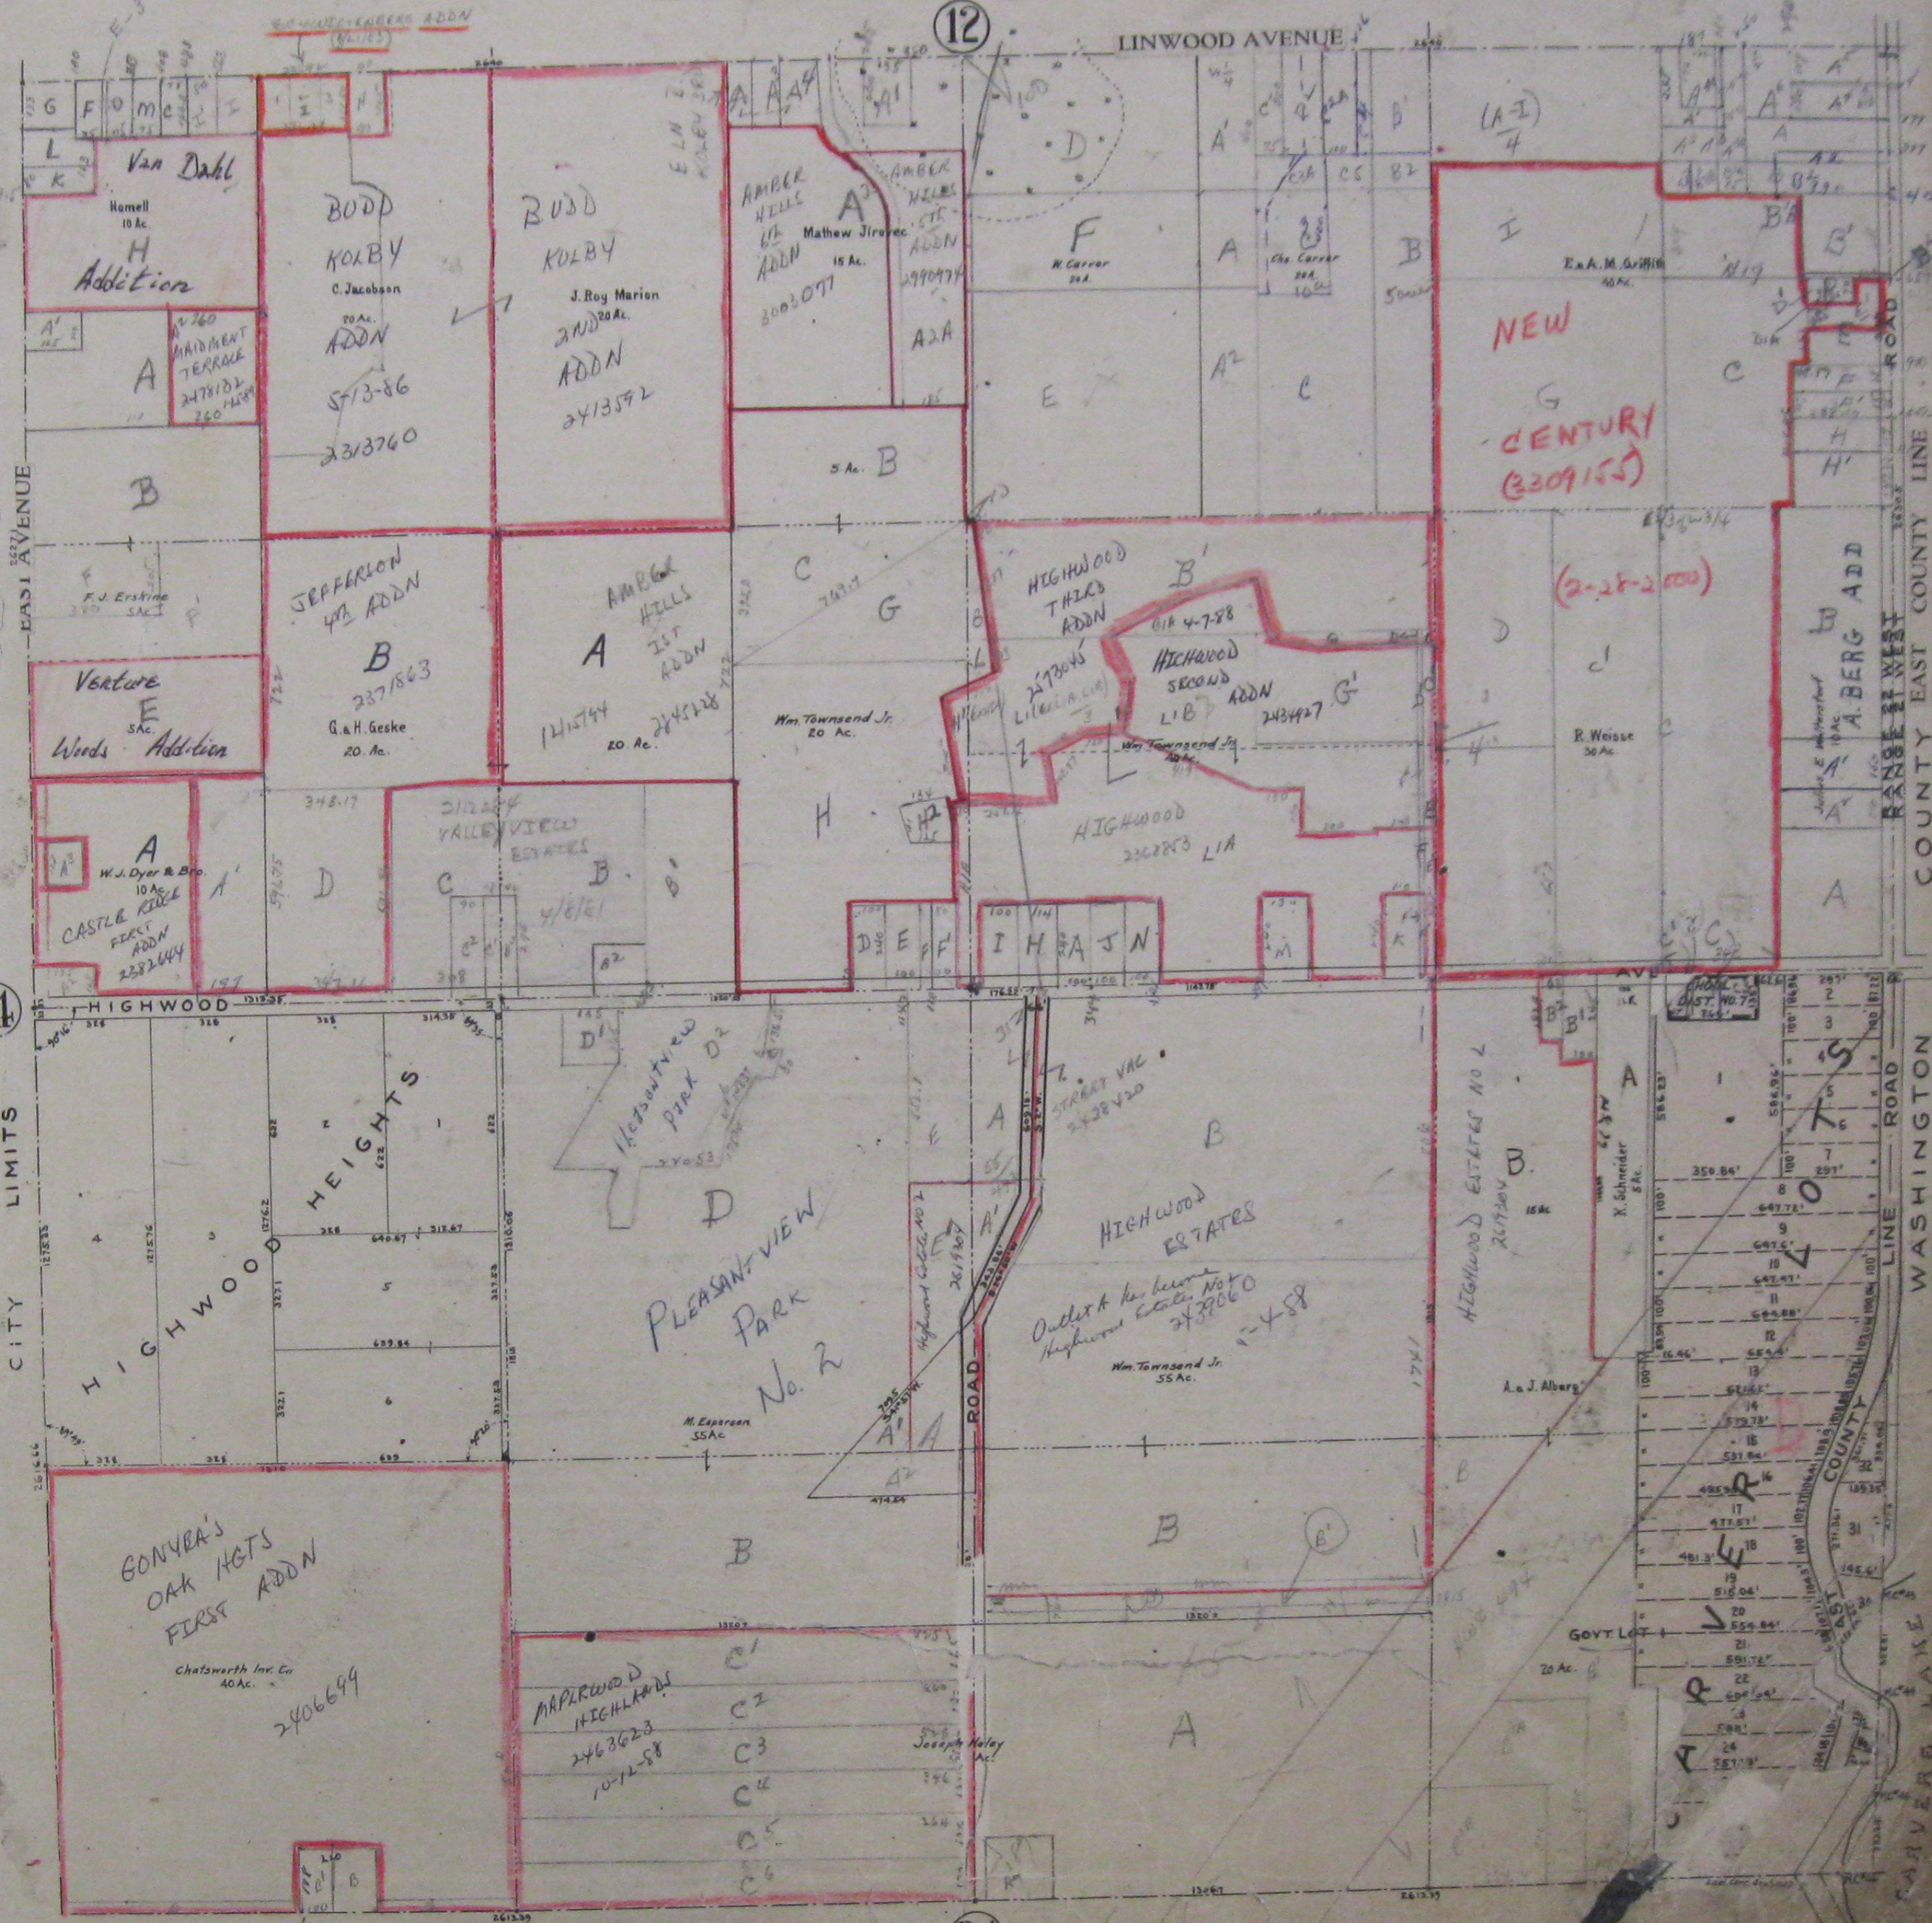

14

CITY LIMITS

13-28-22

24