


SECTION 9, T.29, R.22 X

4

8

10

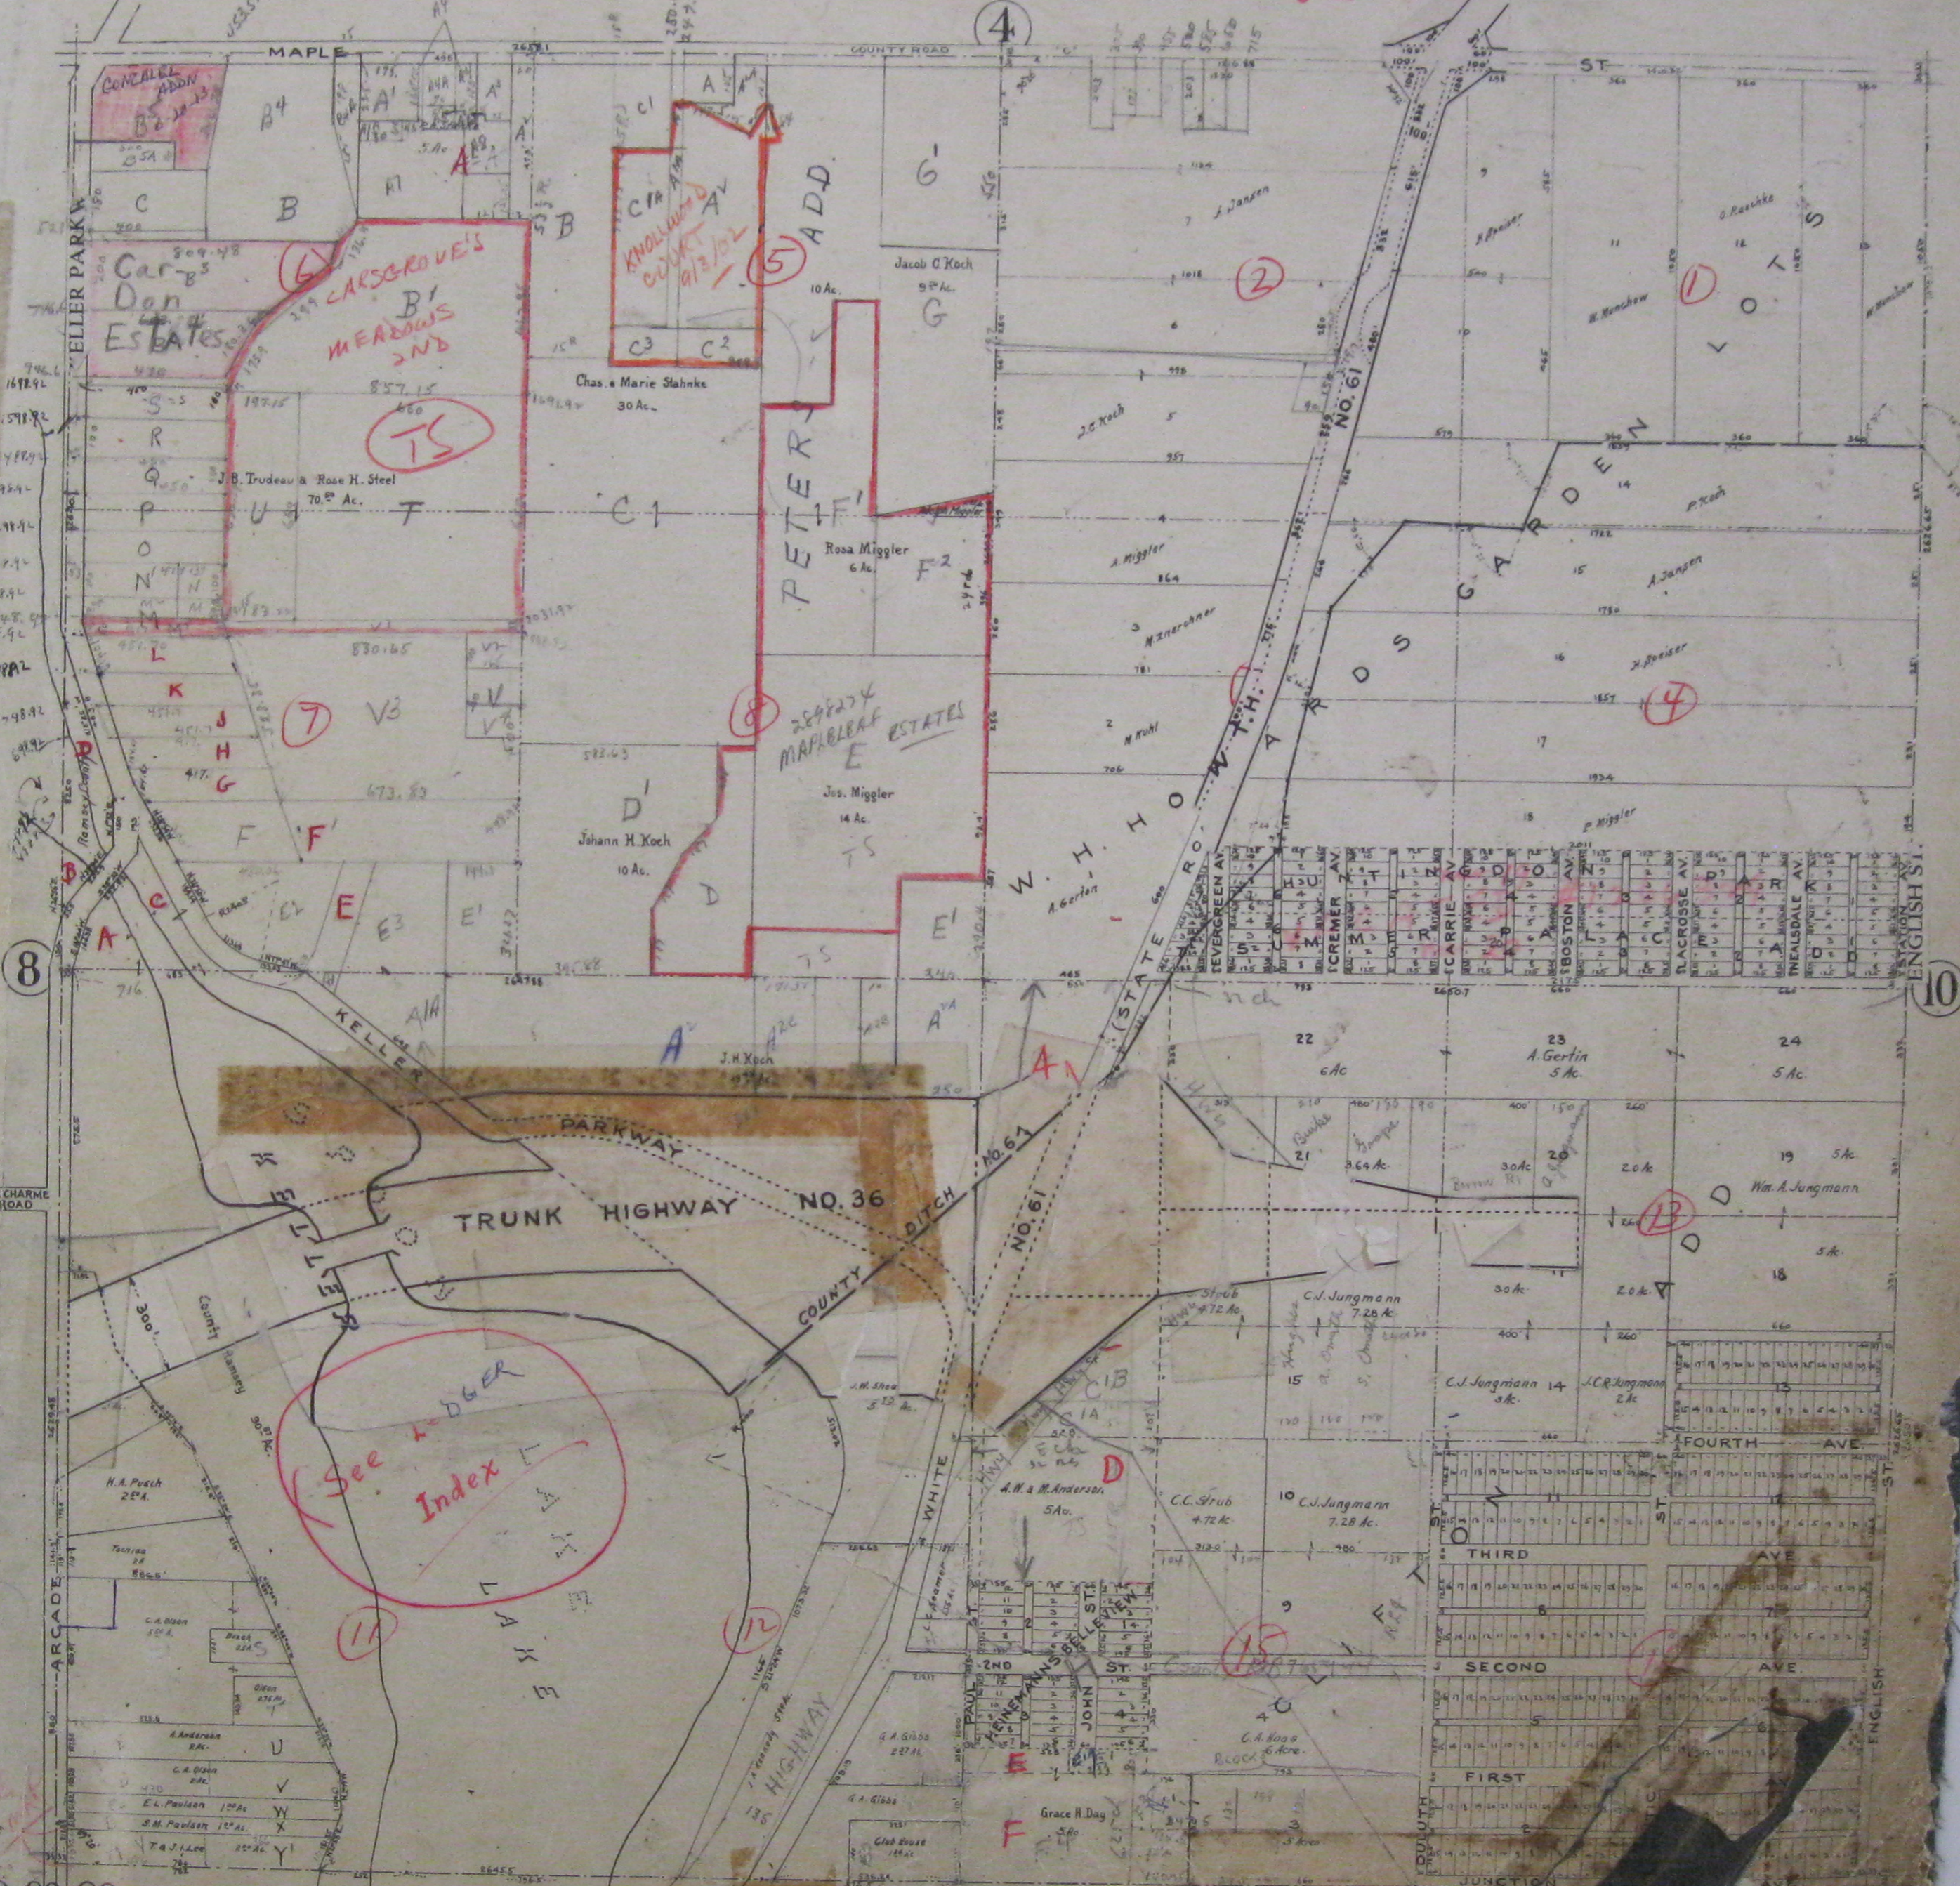

See Index

9-29-22.

16