




SECTION 24, T. 29, R. 22.

13

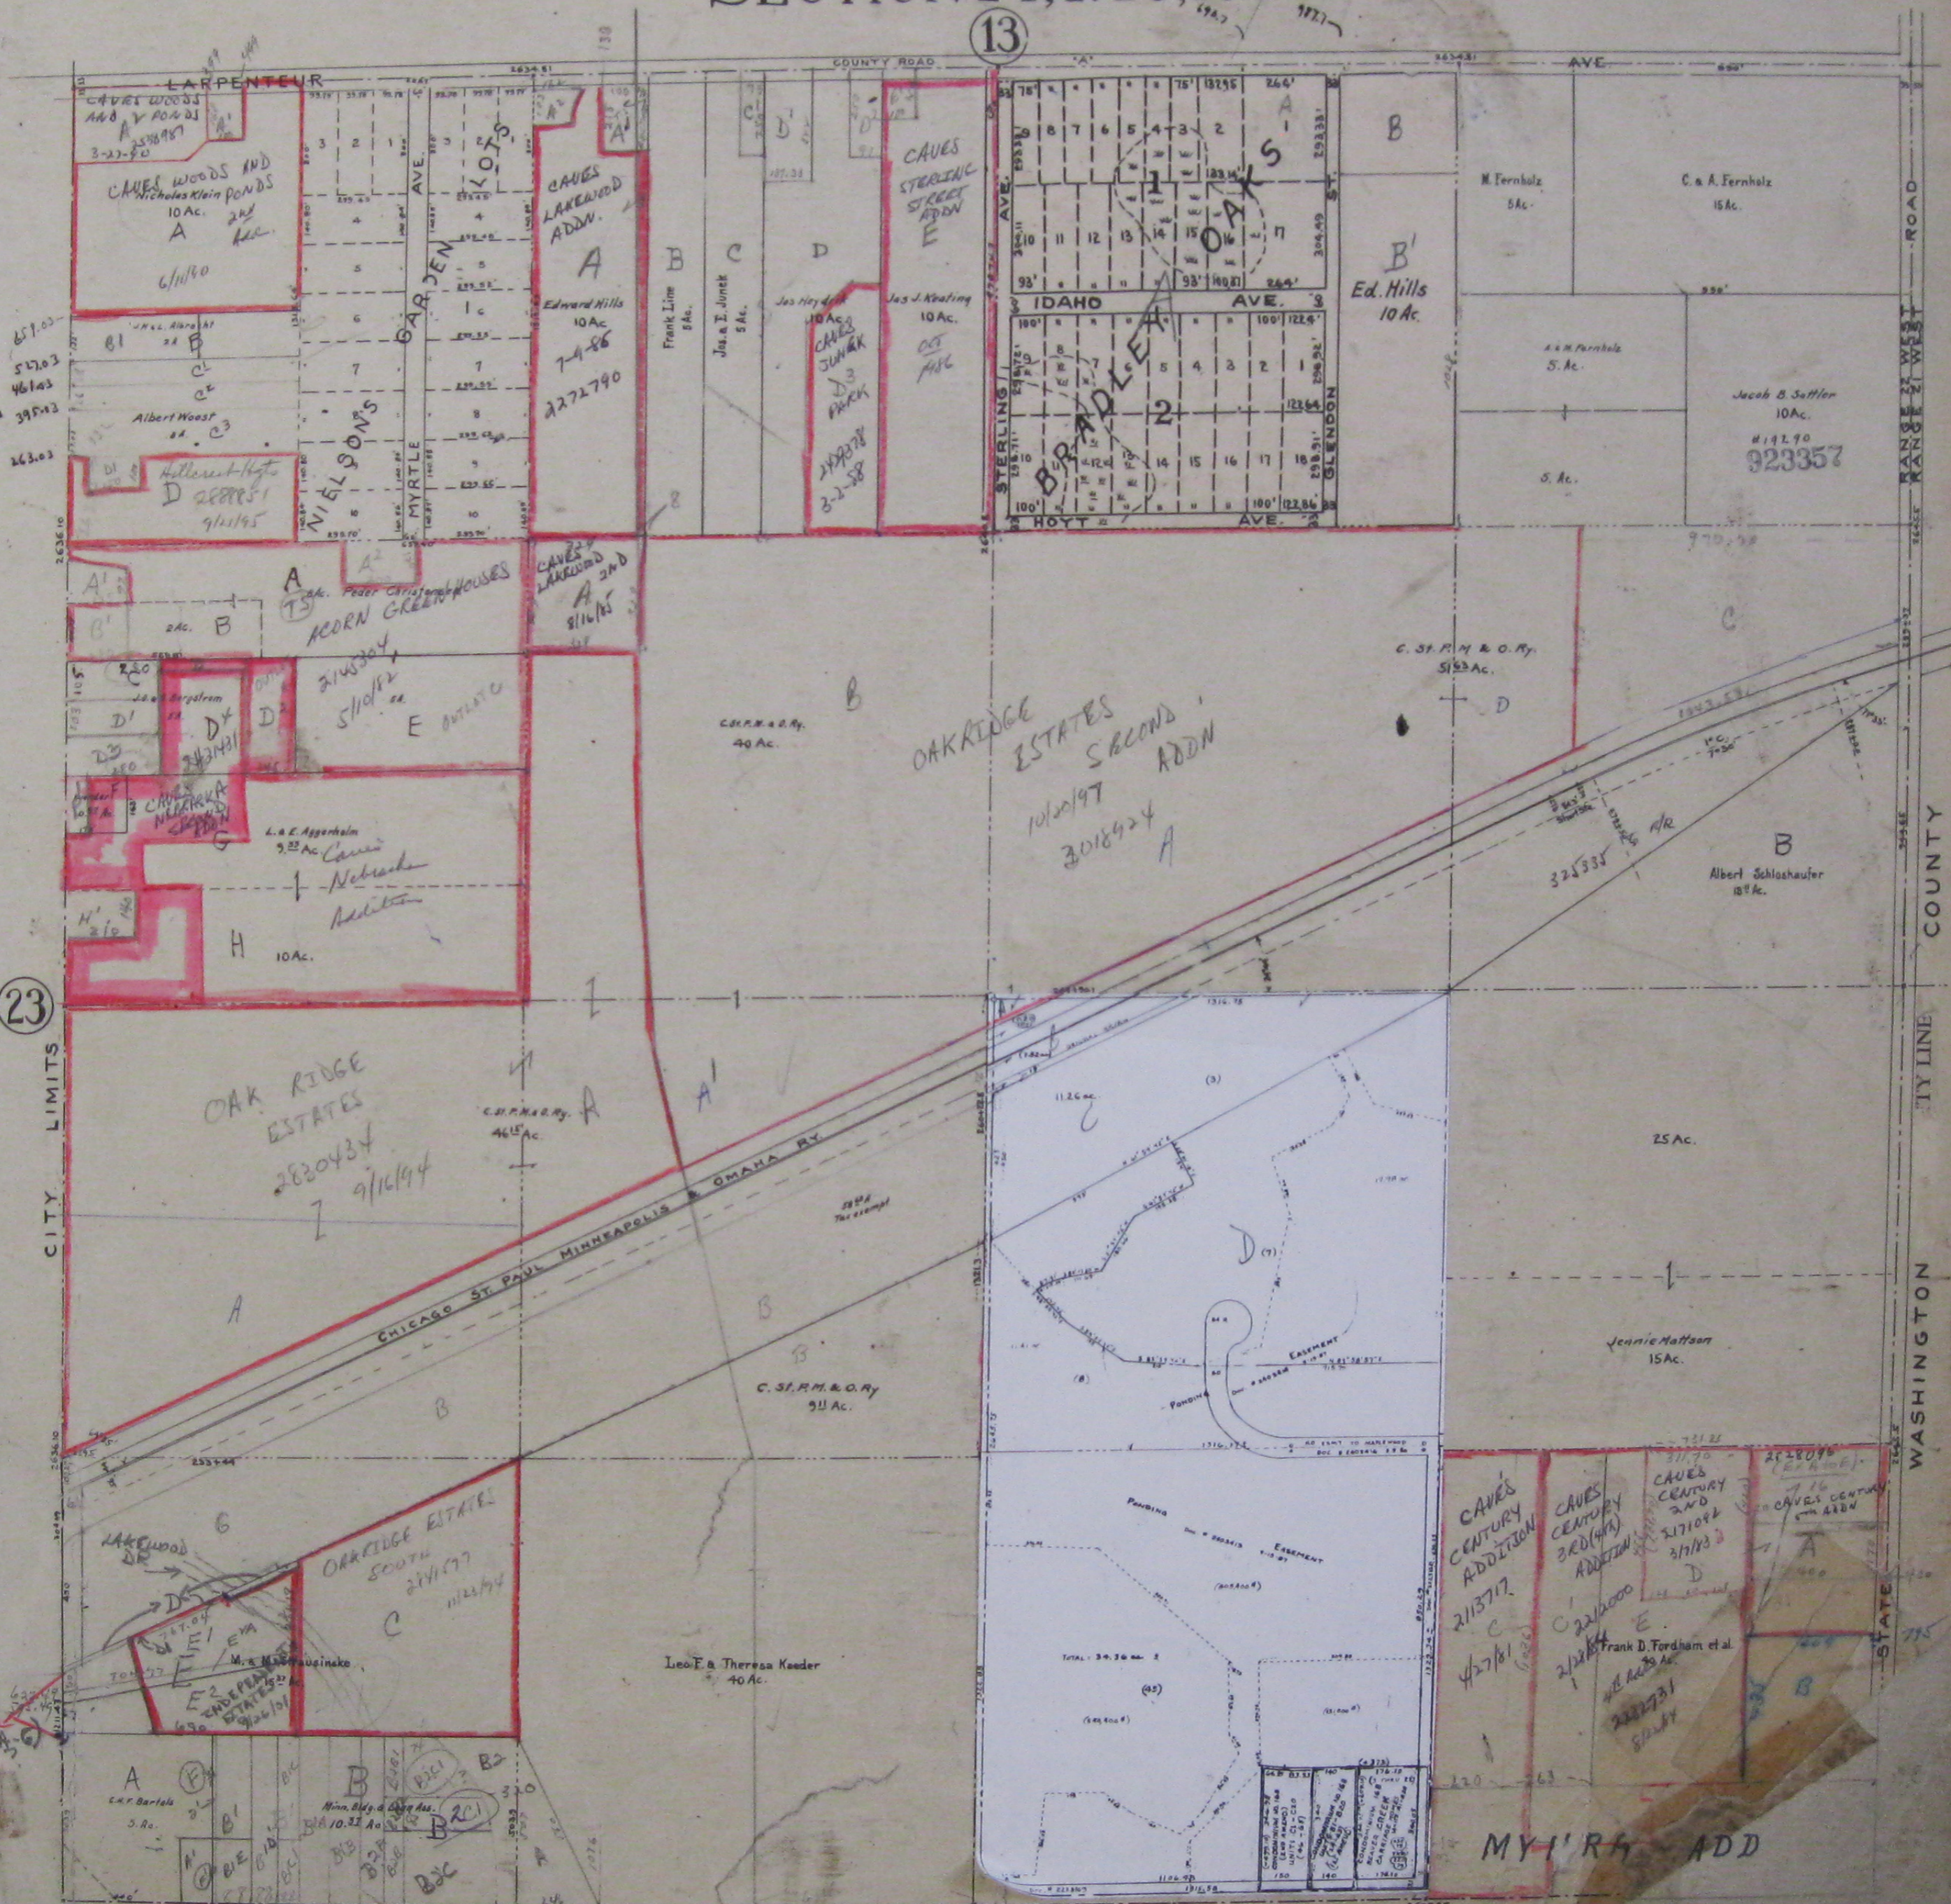

23

24-29-22

25

COUNTY ROAD  
RANGE 21 WEST  
COUNTY  
WASHINGTON