


SECTION 12, T. 29, R. 23 X

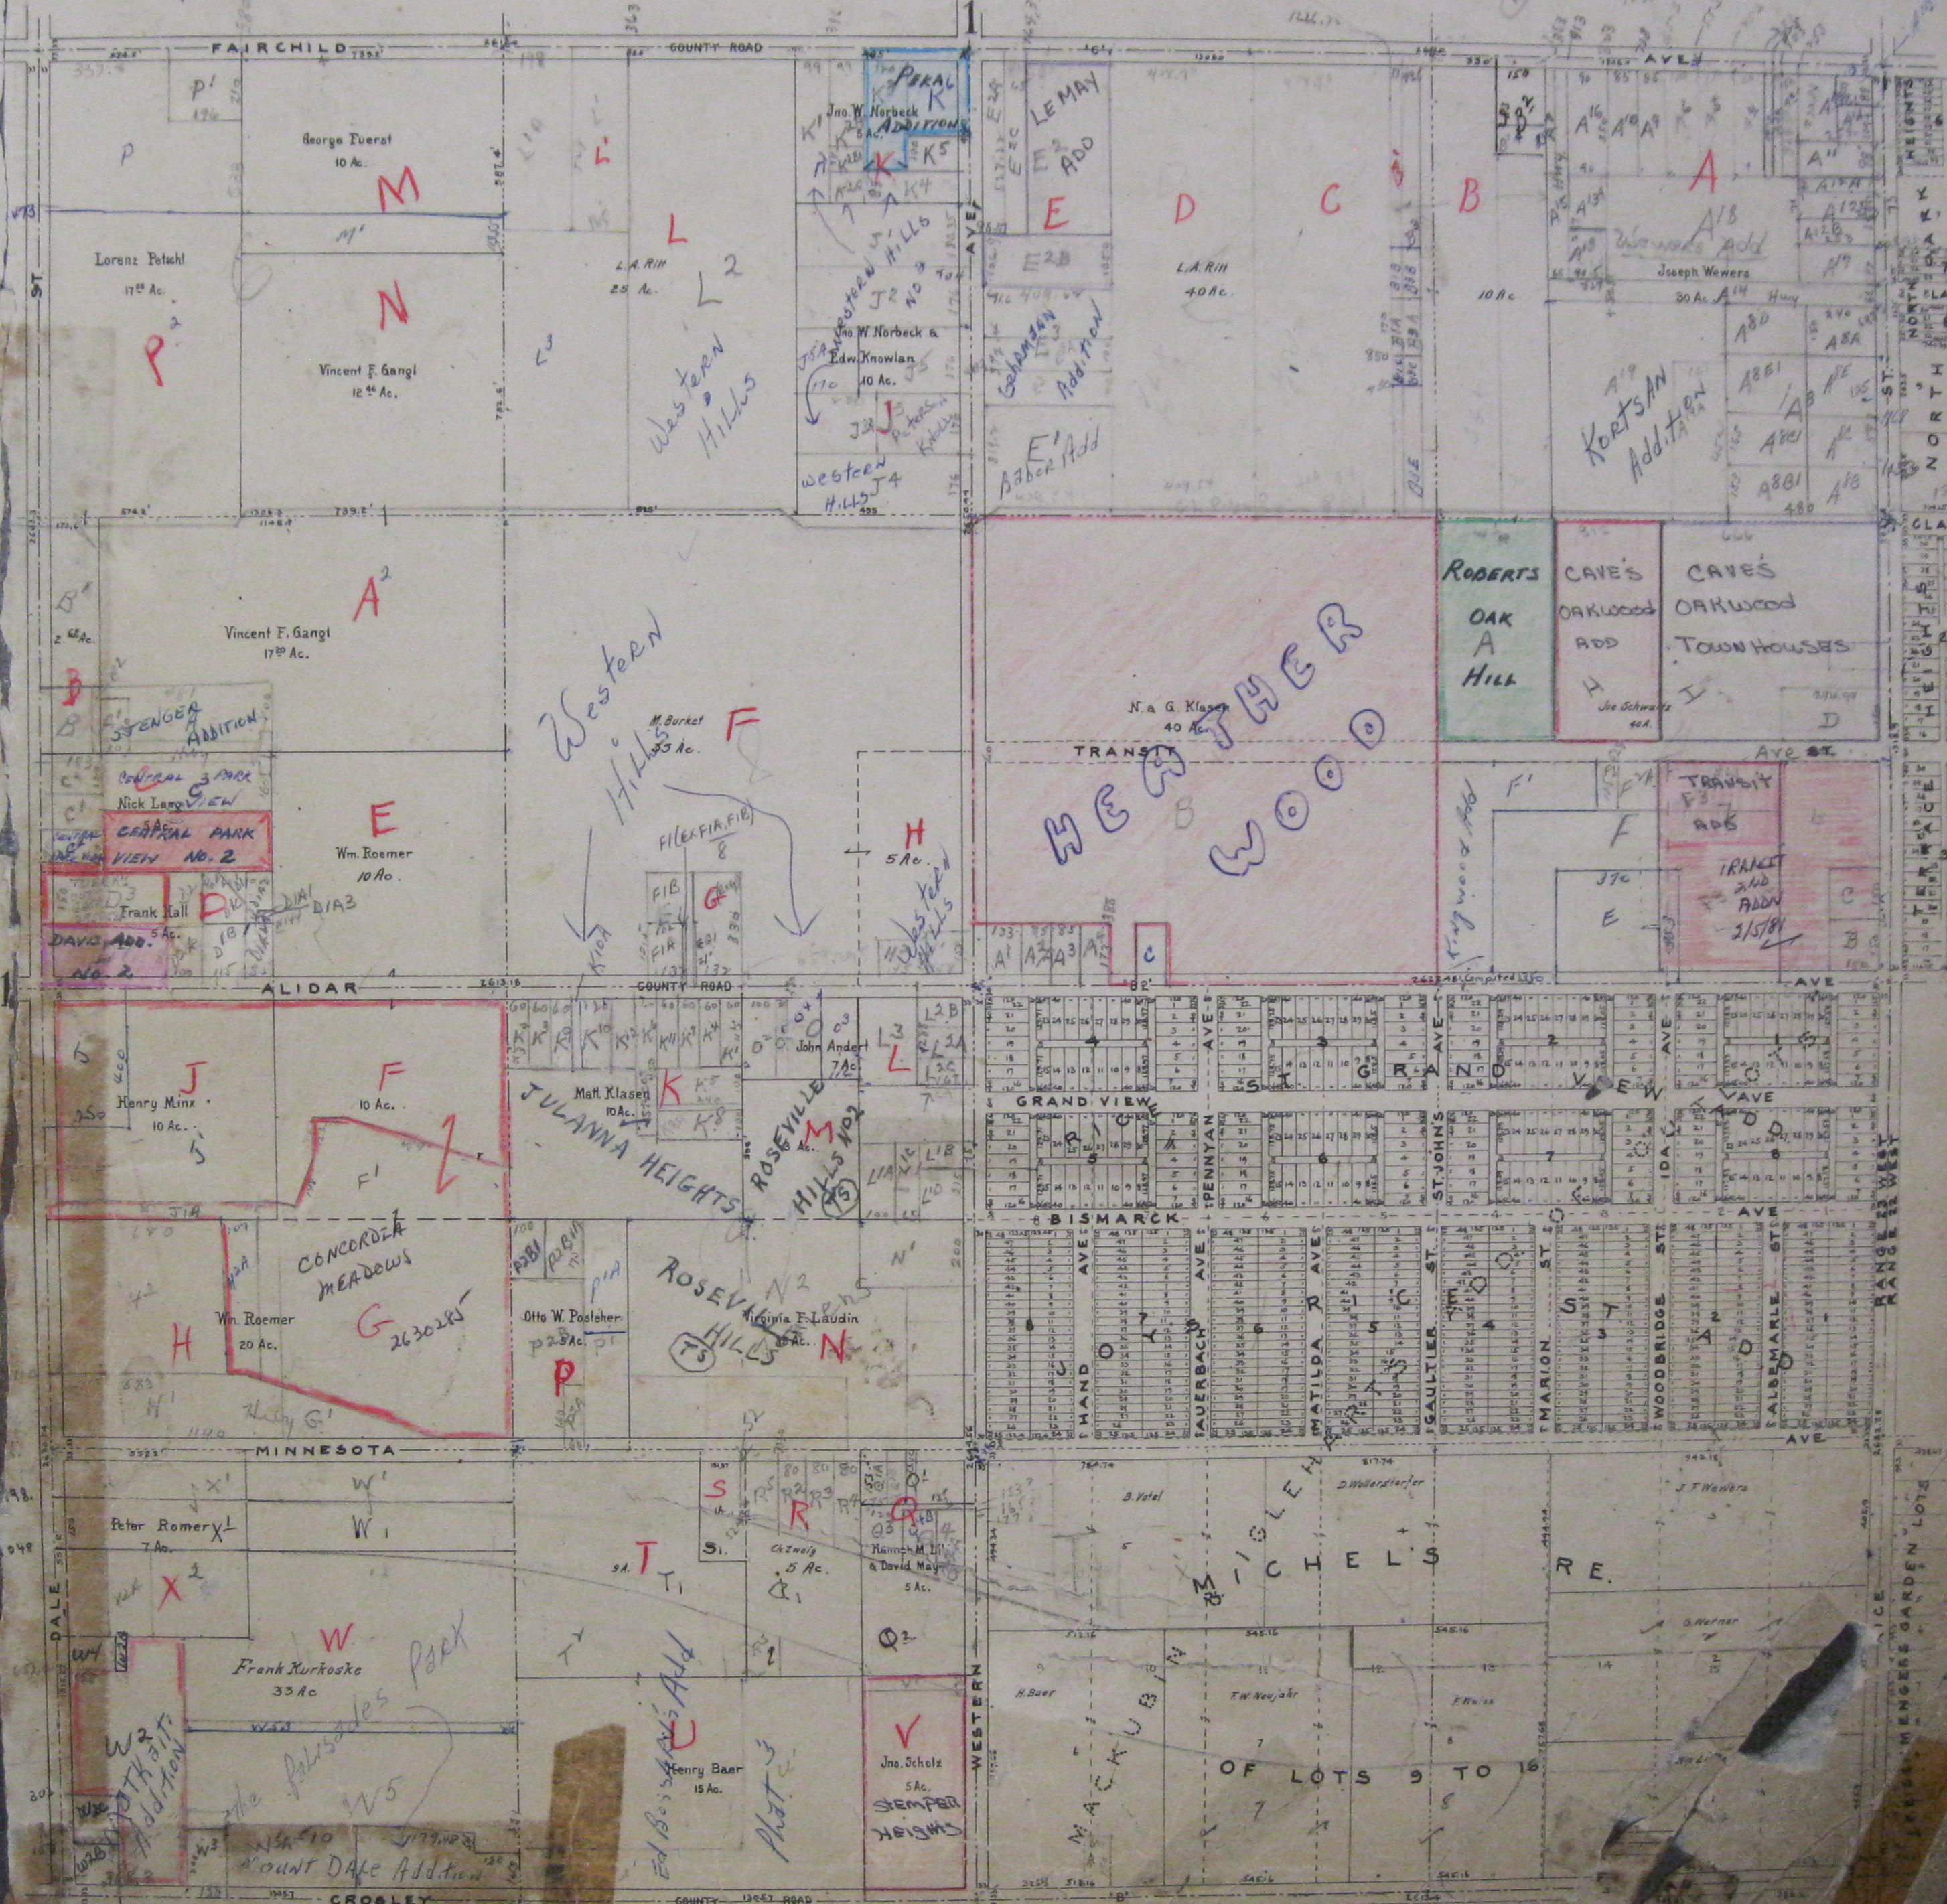

12-29-23.

13

THORNTON'S SUB