


SECTION 14, T.29, R.23, X

11

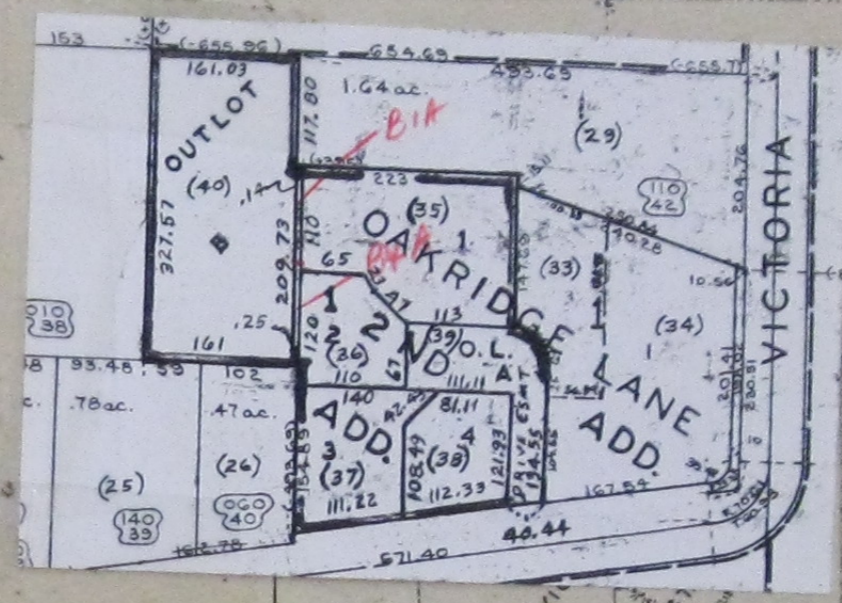

15  
131.91  
263.98  
395.97  
527.16  
679.95

